

SURVEY & REMONUMENTATION

LIBER 14833 PG 148

MAY - 1 1995 LAND CORNER RECORDATION CERTIFICATE
Filing Requirement of Act 74, Mich. P.A. 1970

94 193392

OK - T. SMITH

For corners in
Oakland

COMMISSION

| (County) | Located In: | Corner Code # |
|---------------------------------------|-------------|---------------|
| | 5N 11E | C-3 |
| 1. Public Land Survey | T R | |
| | T R | |
| | T R | |
| | T R | |
| 2. Property Controlling in Section | S T R | |
| | S T R | |
| 3. Miscellaneous Property in Sec. | S T R | |
| | S T R | |

\$ 7.00 MISCELLANEOUS RECORDING
\$ 2.00 REMONUMENTATION
15 JUL 94 7:37 A.M. RECEIPT# 1A
PAID RECORDED - OAKLAND COUNTY
LYNN D. ALLEN, CLERK/REGISTER OF DEEDS
ACT 345, P.A. 1990

APPROVED ON: 7-11-94
OAKLAND COUNTY REMONUMENTATION
PEER GROUP COMMITTEE
Register of Deeds Stamp & File Number

4. Lot No. , Recorded Plat
5. Private Claims

Bruce Antcliff

November 10

93

I, , in a field survey on , 19 ,
do hereby certify that under requirements of P.A. 74, Michigan P.A. of 1970, the corner points mentioned
in lines 1 and 2 above were in conformance with regulations and rules therefore as required in the
current manual of survey instructions of the United States Department of the Interior, Bureau of Land
Management or by a decree of a Court of Law and/or that the corner points mentioned in lines 3, 4 and 5
above were in conformance with the rules of the Michigan Board of Land Surveyors or by a Decree of a
Court of Law; established, re-established, monumented, re-monumented, recovered, found as
expressed below:

NOTE: Not more than 4 corners, all in the same town and range, may be recorded
on this certificate.

| | A | B | C | D | E | F | G | H | I | J | K | L |
|----|----|---|----|---|----|---|----|---|----|---|----|---|
| 2 | 6 | | 5 | | 4 | | 3 | | 2 | | 1 | |
| 3 | | | | | | | | | | | | |
| 4 | 7 | | 8 | | 9 | | 10 | | 11 | | 12 | |
| 5 | | | | | | | | | | | | |
| 6 | 18 | | 17 | | 16 | | 15 | | 14 | | 13 | |
| 7 | | | | | | | | | | | | |
| 8 | 19 | | 20 | | 21 | | 22 | | 23 | | 24 | |
| 9 | | | | | | | | | | | | |
| 10 | 30 | | 29 | | 28 | | 27 | | 26 | | 25 | |
| 11 | | | | | | | | | | | | |
| 12 | 31 | | 32 | | 33 | | 34 | | 35 | | 36 | |
| 13 | | | | | | | | | | | | |

A. Description of original monument and accessories and/or subsequent restoration:

C-3 GLO
Post

L.C.R.C. L. 5971, P. 21 (1972)
Fnd 1/2" Iron Rod
S 40° W - 73.96' Power Pole
S 70° E - 86.9' 12" Butternut
S 45° E - 37.49' Fence Post

L.C.R.C. L. 11996, P.027 (1991)
Fnd 1/2" Iron Rod
N 30° E - 103.68' 38" Oak
S 20° E - 61.69' Power Pole
S 80° E - 86.54' 15" Oak

Survey: H. Kennedy (4/22/80)
Same as L.C.R.C. L. 11996, P. 027

B. Description of corner evidence found and/or method applied in restoring or reestablishing corner:

C-3 Found 1/2" iron bar at centerline intersection (2) gravel roads (Hosner Road N - S) (Oakwood Road E - W).
Checks the following witnesses:

L.C.R.C. L. 5971, P. 21
S 40° W - 73.96' Power Pole

L.C.R.C. L. 11996, P.027
S 20° E - 61.69' Power Pole


Survey: H. Kennedy (4/22/80)
S 20° E - 61.69' Power Pole

C. Description of monument for corner and accessories established to perpetuate locating the position of the corner:

C-3 The selected location of a corner, although not established by an original government survey,
is accepted as the best available evidence of the position of the corner.

Set 5/8" rebar with standard Oakland County cap.

P.K. Nail and Brass Tag in SW Face Triple 10" Oak - S 15° E - 70.87'
P.K. Nail and Brass Tag in E Face 15" Ash - S 35° W - 88.66'
P.K. Nail and Brass Tag in SE Face Light Pole - S 75° W - 118.71'
P.K. Nail and Brass Tag in SW Face Power Pole - N 37° W - 137.03'

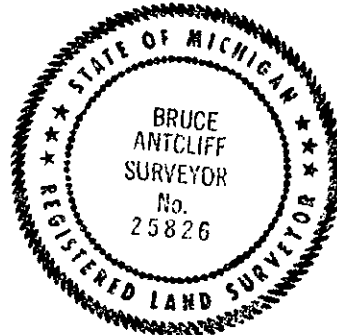

Signed by Bruce Antcliff
Surveyor's Michigan License No. 25826

Date 7-11-94