

SURVEY & REMONUMENTATION

LIBER 14833 PG 110

MAY - 1 1995

LAND CORNER RECORDATION CERTIFICATE Filing Requirement of Act 74, Mich. P.A. 1970

94 193354
OK - T. SMITH

For corners in
Oakland

COMMISSION

(County)	Located In:		Corner Code #
	5N	11E	
1. Public Land Survey	T	R	H-3
	T	R	
	T	R	
	T	R	
2. Property Controlling in Section	S	T	R
	S	T	R
3. Miscellaneous Property in Sec.	S	T	R
	S	T	R

Compliance with
ACT 345, P.A. 1990

APPROVED ON: 12-15-93
OAKLAND COUNTY REMONUMENTATION
PEER GROUP COMMITTEE

Register of Deeds Stamp & File Number

4. Lot No. _____, Recorded Plat _____
5. Private Claims _____

	A	B	C	D	E	F	G	H	I	J	K	L	M
2	6	5	4	3	2	1							
3													
4	7	8	9	10	11	12							
5													
6	18	17	16	15	14	13							
7													
8	19	20	21	22	23	24							
9													
10	30	29	28	27	26	25							
11													
12	31	32	33	34	35	36							
13													

Bruce Antcliff

November 15

93

I, _____, in a field survey on _____, 19_____, do hereby certify that under requirements of P.A. 74, Michigan P.A. of 1970, the corner points mentioned in lines 1 and 2 above were in conformance with regulations and rules therefore as required in the current manual of survey instructions of the United States Department of the Interior, Bureau of Land Management or by a decree of a Court of Law and/or that the corner points mentioned in lines 3, 4 and 5 above were in conformance with the rules of the Michigan Board of Land Surveyors or by a Decree of a Court of Law; established, re-established, monumented, re-monumented, recovered, found as expressed below:

NOTE: Not more than 4 corners, all in the same town and range, may be recorded on this certificate.

A. Description of original monument and accessories and/or subsequent restoration:

H-3 GLO
Post

L.C.R.C. L. 7941, P. 343 (1976)
1/2" Iron
N 7.6 ft. Cluster of trees
N 80° W 20.0 ft. 8" Tree
N 60° W 16.82 ft. Double 15" Oak

Survey recorded in L. 6345, P. 389
1/2" Iron
N 7.6 ft. Cluster of trees
N 80° W 20.0 ft. 8" Tree
N 60° W 16.82 ft. Double 15" Oak

B. Description of corner evidence found and/or method applied in restoring or reestablishing corner:

H-3 Found 1/2" Rebar in fence intersection East, West & North, with field line South.
Checks the following witnesses:

L.C.R.C. L. 7941, P. 343 (1976)
Double 15" Oak - N 60° W - 16.82'


Checked map of survey as recorded in L. 6345, P. 389

C. Description of monument for corner and accessories established to perpetuate locating the position of the corner:

H-3 The selected location is accepted by the Contractor and is generally accepted by professional surveyors as the best available evidence of the position of the original corner.

Set concrete monument with standard Oakland County cap.

P.K. Nail and Brass Tag in S. face 18" Tw. Oak - N 70° W - 16.79'
P.K. Nail and Brass Tag in NW face 12" Oak - N 60° E - 20.21'
P.K. Nail and Brass Tag in W face 8" Ash - S 15° W - 18.19'
P.K. Nail and Brass Tag in E face 6" Maple - N 20° W - 28.77'

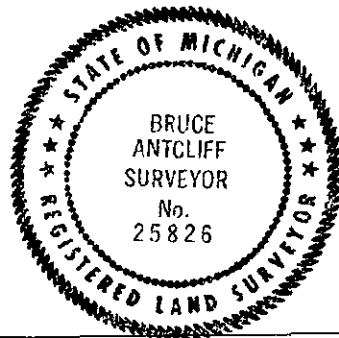

Signed by Bruce Antcliff
Surveyor's Michigan License No. 25826

Date 7-11-94