

# SURVEY & REMONUMENTATION

LIBER 14833 PG 126

94 193370

MAY - 1 1995

## LAND CORNER RECORDATION CERTIFICATE

Filing Requirement of Act 74, Mich. P.A. 1970

OK - T. SMITH

For corners in  
Oakland

### COMMISSION

(County)	Located In:		Corner Code #
	5N	11E	
1. Public Land Survey	T	R	L-3
	T	R	
	T	R	
	T	R	
2. Property Controlling in Section	S	T	R
	S	T	R
3. Miscellaneous Property in Sec.	S	T	R
	S	T	R

\$ 7.00 MISCELLANEOUS RECORDING

\$ 2.00 REMONUMENTATION

15 JUL 94 7:29 A.M. RECEIPT# 1A

PAID RECORDED - OAKLAND COUNTY

LYNN D. ALLEN, CLERK/REGISTER OF DEEDS

ACT 345, P.A. 1990

APPROVED ON: 2-2-94  
OAKLAND COUNTY REMONUMENTATION  
PEER GROUP COMMITTEE

Register of Deeds Stamp & File Number

4. Lot No. \_\_\_\_\_, Recorded Plat \_\_\_\_\_  
5. Private Claims \_\_\_\_\_

Bruce Antcliff

November 4

93

I, \_\_\_\_\_, in a field survey on \_\_\_\_\_, 19 \_\_\_\_\_,  
do hereby certify that under requirements of P.A. 74, Michigan P.A. of 1970, the corner points mentioned  
in lines 1 and 2 above were in conformance with regulations and rules therefore as required in the  
current manual of survey instructions of the United States Department of the Interior, Bureau of Land  
Management or by a decree of a Court of Law and/or that the corner points mentioned in lines 3, 4 and 5  
above were in conformance with the rules of the Michigan Board of Land Surveyors or by a Decree of a  
Court of Law; established, re-established, monumented, re-monumented, recovered, found as  
expressed below:

**NOTE: Not more than 4 corners, all in the same town and range, may be recorded  
on this certificate.**

#### A. Description of original monument and accessories and/or subsequent restoration:

L-3 GLO  
Post

Survey L. 6278, P. 795 (1974)  
Conc. Monument  
No Witnesses Shown

L.C.R.C. L. 9840, P. 341 (1987)  
Conc. Monument  
S 04° E 16.62 Nail W Side 8" Tree  
S 17° W 46.0 Spk E Side 20" Tree  
N 30° W 49.46 Spk E Side Util. Pole  
N 48° W 41.84 Spk NE Side 18" Oak

#### B. Description of corner evidence found and/or method applied in restoring or reestablishing corner:

L-3 Found concrete monument 40' M/L East of the center line of Secord Lake Road as shown on Secord Lakeview Subdivision  
No. 27 recorded in Liber 68, P. 31 (1953).  
Checks the following witness:


L.C.R.C. L. 9840, P. 341 (1987)  
S 17° W 46.0 Spk E Side 20" Tree  
N 30° W 49.46 Spk E Side Util. Pole  
N 48° W 41.84 Spk NE Side 18" Oak

#### C. Description of monument for corner and accessories established to perpetuate locating the position of the corner:

L-3 The selected location is accepted by the Contractor and is generally accepted by professional  
surveyors as the best available evidence of the position of the original corner.

Set standard Oakland County cap on existing concrete monument.

P.K. Nail and Brass Tag in E Side 20" Poplar - S 20° W - 46.07  
Cor Chain Link Fence - N 70° W - 87.44  
P.K. Nail and Brass Tag in 20" Oak - N 45° W - 42.12  
P.K. Nail and Brass Tag in P. Pole - N 30° W - 49.45

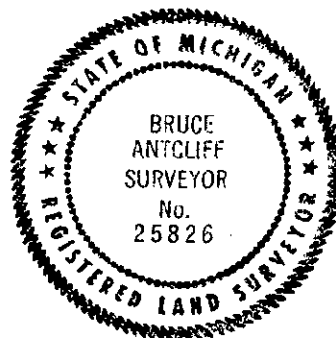

Signed by

*Bruce Antcliff*

25826

Date

7-11-94

Surveyor's Michigan License No. \_\_\_\_\_