

SURVEY & REMONUMENTATION

OCT 27 1993

COMMISSION

OCEANA COUNTY REMONUMENTATION
LAND CORNER RECORDATION CERTIFICATE
Filing Requirement of Act 74, Mich. P.A. 1970

STATE OF MICHIGAN
COUNTY OF OCEANA
RECEIVED FOR RECORD

100514

'93 OCT -7 P2:46

or corners in
OCEANA

(County)

Located in:

Corner Code #

Public Land Survey

T15N R18W

I-9

Property Controlling
in Section

S T R

Miscellaneous

S T R

Property in Sec.

S T R

James E. Martin
REGISTER OF DEEDS

Register of Deeds Stamp & File Number

Lot No. , Recorded Plat

Private Claims

J. Randolph Hepworth In a field survey on September 27, 1993

whereby certify that under requirements of P.A. 74, Michigan P.A. of 1970, the corner points mentioned in lines 1 and 2 above were in conformance with regulations and rules therefore as required in the current manual of survey instructions of the United States Department of the Interior, Bureau of Land Management or by a decree of a Court of Law and/or that the corner points mentioned in lines 3, 4 and 5 above were in conformance with the rules of the Michigan Board of Land Surveyors or by a Decree of a Court of Law; established, re-established, monumented, re-monumented, recovered, found as pressed below:

NOTE: Not more than 4 corners, all in the same town and range, may be recorded on this certificate.

Description of original monument and accessories and/or subsequent restoration:

A. I-9 CORNER COMMON TO SECTIONS 22, 23, 26 & 27 GOLDEN TWP T15N, R18W
GLO- SET POST 19" BEECH N43°E 25.7' 10" BEECH N47°W 15.2'
BOOK A-175 BN HYDE APRIL, 1887 SET 5" SQ SANDSTONE 18" LONG WITH BROKEN CROCKERY
BOOK A-298 HA GRANT, OCT, 1891 STONE PREVIOUSLY SET - NO WITNESSES RECITED
BOOK A-366 HA GRANT, MAY, 1894 STONE PREVIOUSLY SET - NO WITNESSES RECITED
BOOK A-382 HA GRANT APRIL, 1895 STONE PREVIOUSLY SET - NO WITNESSES RECITED
OCEANA ROAD COMMISSION: LG STONE & IRON ON W SIDE PRE-1950
12" TW ELM N10°W 61.0'
12" TW OAK N40°E 64.0' STILL STANDING IN 1993

B. Description of corner evidence found and/or method applied in restoring or reestablishing corner

FOUND 1/2" IRON BY ROSS, LS17634 WAS ESTABLISHED USING IMPROPER PROCEDURES AND IS NOT UTILIZED IN THIS SURVEY.
C/L GRAVEL ROAD INTERSECTION

FOUND 6"X6" GRANITE STONE WITH SMALL POINT UP 4' BELOW SURFACE AND IS ACCEPTED AS A CAREFUL AND FAITHFUL PERPETUATION OF THE POSITION OF THE ORIGINAL CORNER. A 1" PIPE WAS FOUND 2.5' EAST OF STONE- (NOT ACCEPTED).

C. Description of monument for corner and accessories established to perpetuate locating the position of the corner.

C. I-9 CORNER COMMON TO SECTIONS 22, 23, 26, 27 T15N, R18W
SET "COUNTY SURVEYOR" HARRISON 4"X20" CAST IRON MONUMENT ON TOP OF FOUND STONE

60d SPK SW FACE	POWER POLE	S53°E	49.56	EDM
60d SPK SE FACE	24" TW W OAK	N34°E	64.68	EDM
60d SPK S FACE	POWER POLE	N71°W	136.53	EDM
CENTER	ROAD NAME SIGN	N50°W	62.18	EDM
60d SPK SE FACE	16" POPLAR	S41°W	38.21	TAPE
60d SPK S FACE	POWER POLE	N66°E	108.72	EDM
1/2" IRON, ROSS LS17634 IS 6.90' N & 3.70' E				


igned by

Date

September 30, 1993

urveyor's Michigan License No. 26457

FORM APPROVED BY MICHIGAN STATE BOARD OF LAND SURVEYORS, JAN. 28, 1971

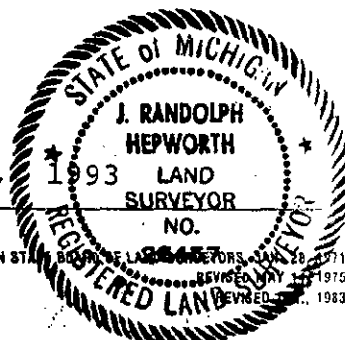

11-5-93