


LAND CORNER RECORDATION CERTIFICATE

Filing Requirement of Act 74, Mich. PA 1970

For Corners In: Ogemaw (County)	Located In	Corner Code #
1. Public Land Survey	T _____ R _____ T _____ R _____	_____
2. Property Controlling in Section	S 28 T 23N R 2E S 28 T 23N R 2E	4 8
3. Miscellaneous Property in Section	S _____ T _____ R _____ S _____ T _____ R _____	_____
4. Lot No: _____	Recorded Plat: _____	
5. Private Claims: _____		

I, Carl T. Kiiskila, in a field survey on November 13, 2008 do hereby state that under requirements of PA 74, Michigan PA of 1970, the corner points mentioned in lines 1 and 2 above were in conformance with regulations and rules therefore as required in the current manual of survey instructions of the United States Department of the Interior, Bureau of Land Management or by a decree of a Court of Law and/or that the corner points mentioned in lines 3, 4 and 5 above were in conformance with the rules of the Michigan Board of Land Surveyors or by a Decree of a Court of Law; established, re-established, monumented, recovered, found as expressed below:

NOTE: Not more than 2 corners, all in the same town and range, may be recorded on this certificate.

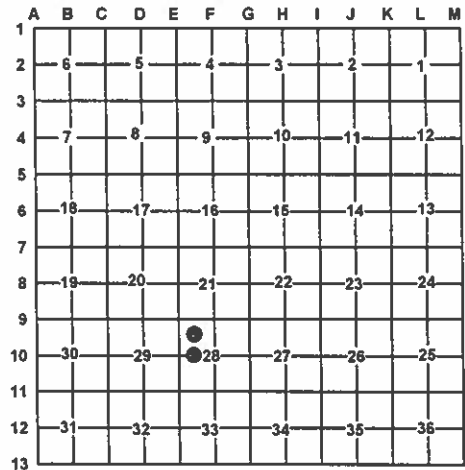

Register of Deeds Stamp & File Number

A. Description of original monument and accessories and/or subsequent restoration:

4 NW 1/16 Cor. Sec. 28, T23N, R2E

8 CW 1/16 Cor. Sec.28, T23N, R2E

This corner position was not established during the original Government Survey.

This corner position was not established during the original Government Survey.

B. Description of corner evidence found and/or method applies in restoring or re-establishing corner:

4 Set 5/8"x32" rebar with P.S.cap#33981 per standard BLM procedure.

8 Set 5/8"x32" rebar with P.S.cap#33981 per standard BLM procedure.

C. Description of monument for corner and accessories established to perpetuate locating the position of the corner:

4 5/8"x32" rebar with P.S.cap#33981

Wit: 7" Beech N18°W 22.31' (set N&T on E side)
22" Hemlock S72°E 45.50' (set N&T on N side)
7" Twin Maple S16°E 35.08' (set N&T on W side)
14" Maple S86°W 20.38' (set N&T on S side)
Set Blue Carsonite Post with Loc. Tag 1' North

8 5/8"x32" rebar with P.S.cap#33981

Wit: 18" White Pine N86°E 10.11' (set N&T on S side)
14" Oak N55°W 36.96' (set N&T on S side)
18" Oak N15°W 29.34' (set N&T on W side)
18" Twin Oak S29°W 34.28' (set N&T on E side)
Set Blue Carsonite Post with Loc. Tag 1' North

Signed by:

Carl T. Kiiskila

Surveyor's Michigan License No.:

33981

Date:

6-17-09

