


LAND CORNER RECORDATION CERTIFICATE
Filing Requirement of Act 74, Mich. PA 1970

For Corners In:
Ogemaw
(County)
Located In
Corner Code #
1. Public Land Survey
2. Property Controlling in Section
3. Miscellaneous Property in Section
4. Lot No:
5. Private Claims:

I, Carl T. Kiiskila, in a field survey on November 24, 2008 do hereby state that under requirements of PA 74, Michigan PA of 1970, the corner points mentioned in lines 1 and 2 above were in conformance with regulations and rules therefore as required in the current manual of survey instructions of the United States Department of the Interior, Bureau of Land Management or by a decree of a Court of Law and/or that the corner points mentioned in lines 3, 4 and 5 above were in conformance with the rules of the Michigan Board of Land Surveyors or by a Decree of a Court of Law; established, re-established, monumented, recovered, found as expressed below:

NOTE: Not more than 2 corners, all in the same town and range, may be recorded on this certificate.

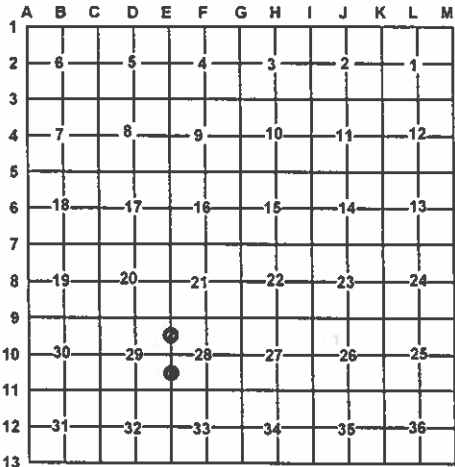

A. Description of original monument and accessories and/or subsequent restoration:
3 N1/16 Cor. Common to Sec's. 28 & 29, T23N, R2E
10 S1/16 Cor. Common to Sec's. 28 & 29, T23N, R2E
This corner position was not established during the original Government Survey.



B. Description of corner evidence found and/or method applies in restoring or re-establishing corner:
3- Set 5/8"x34" rebar with P.S.cap#33981 per standard BLM procedure. Corner falls 5' West of N-S C/L 2-track. Found no other evidence to dispute the location for the position of the corner.
10- Set 5/8"x34" rebar with P.S.cap#33981 per standard BLM procedure. Corner falls 1' East of N-S C/L 2-track. Found no other evidence to dispute the location for the position of the corner.

C. Description of monument for corner and accessories established to perpetuate locating the position of the corner:
3- 5/8"x34" rebar with P.S.cap#33981
Wit: N52°E 53.81' to set N&T on N side 14" Oak
S61°E 51.20' to set N&T on N side 18" Red Oak
S34°W 35.32' to set N&T on W side 8" Maple
N60°W 37.49' to set N&T on NE side 6" Maple
S86°W 1.64' to 1/2" iron bar
Set Blue Carsonite Post with Loc. Tag 33' West
10- 5/8"x34" rebar with P.S.cap#33981
Wit: N41°W 48.90' to set N&T on NE side 4"x11" Tw. Maple
N76°E 12.77' to set N&T on NW side 24" W. Pine
S43°E 51.45' to set N&T on N side 9" R. Pine
S78°W 98.23' to NE corner of Cabin foundation
Set Blue Carsonite with Loc. Tag 33' West

Signed by: [Signature] Date: 6-17-09
Surveyor's Michigan License No.: 33981