

LAND CORNER RECORDATION CERTIFICATE
Filing Requirement of Act 74, Mich. P.A. 1970

For corners in
OGEMAN
(County)

Located In:

Corner Code ##

1. Public Land Survey T 21N R 2E H-11, I-11, J-11
T R
T R
T R
2. Property Controlling S 35 T R 1
in Section S T R
3. Miscellaneous S T R
Property in Sec. S T R

Register of Deeds Stamp & File Number

4. Lot No. , Recorded Plat
5. Private Claims

I, CARL F. ROSER, in a field survey on OCTOBER 25, 19 93, do hereby certify that under requirements of P.A. 74, Michigan P.A. of 1970, the corner points mentioned in lines 1 and 2 above were in conformance with regulations and rules therefore as required in the current manual of survey instructions of the United States Department of the Interior, Bureau of Land Management or by a decree of a Court of Law and/or that the corner points mentioned in lines 3, 4 and 5 above were in conformance with the rules of the Michigan Board of Land Surveyors or by a Decree of a Court of Law; established, re-established, monumented, re-monumented, recovered, found as expressed below:

NOTE: Not more than 4 corners, all in the same town and range, may be recorded on this certificate.

A. Description of original monument and accessories and/or subsequent restoration:

H-11 I-11 J-11


(NO EVIDENCE OF G.L.O. CORNER, B.T.'S, LINE TREES & TOPOGRAPHY, AS CALLED OUT IN THE G.L.O. LINE NOTES; UNLESS NOTED IN ITEM "B" BELOW.)

	A	B	C	D	E	F	G	H	I	J	K	L	M
2	6	5	4	3	2	1							
3													
4	7	8	9	10	11	12							
5													
6	18	17	16	15	14	13							
7													
8	19	20	21	22	23	24							
9													
10	30	29	28	27	26	25							
11													
12	31	32	33	34	35	36							
13													

1

B. Description of corner evidence found and/or method applied in restoring or reestablishing corner:

H-11	I-11	J-11	1
FD IRON IN MON BOX FOR N 1/4 COR S-34. COR IS IN CTR E-W B.TOP RD (& ON FILL FOR BRIDGE APPROACH). CTR OF SOUTH BOUND CENTERLINE OF I-75 IS 892' EAST.	FD REROD W/RLS CAP, 1' SOUTH OF CTR E-W B.TOP RD FOR NW COR S-35. COR FITS REMAINS OF TWO M. KOIVISTO (MDOT) WITS & ALSO FITS K.J.OSTLING'S (MDNR) 1972 SURVEY OF SEC 35.	FD 1/2" REROD IN APPROX CTR E-W B.TOP RD FOR N 1/4 COR S-35. COR FITS K.J.OSTLING (MDNR) 1972 SURVEY OF S-35 & P.S. J. SPENCER'S 1991 CERT OF SURVEY (L1.5, PG.44) IN NW 1/4 OF NE 1/4 OF SEC 35.	ESTABLISHED NE COR OF W 1/2 OF NW 1/4 S-35 PER STANDARD BLM INSTRUCTIONS. COR FALLS IN CTR E-W B.TOP ROAD

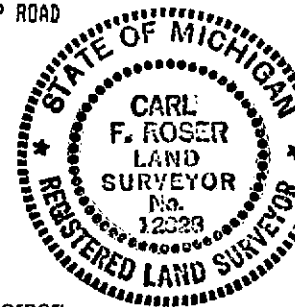

C. Description of monument for corner and accessories established to perpetuate locating the position of the corner:

H-11	I-11	J-11	1
FD 1" DIA SOLID IRON IN MON BOX. PK TOP CTR OF BLK OF WOOD ON STEEL GUARDRAIL POST S30°W 22.07' PK TOP CTR OF BLK OF WOOD ON STEEL GUARDRAIL POST S35°E 24.33'	FD 1/2" REROD W/RLS CAP. POWER POLE S50°E 54.20' 11" W PINE S30°E 85.97' 8" W PINE S05°W 69.55' SET CED POST WITH LOC TAG. SOUTH 33' WIT BY OTHERS.	FD 1/2" REROD. 8" W PINE N15°W 45.93' 9" W PINE NORTHWEST 37.99' 13" ASH S45°W 59.43' CTR OLD M-76 WEST 307'	DR 5/8" X 34" REROD W/RLS CAP. 16" W PINE S20°E 48.73' NE COR LOG CABIN FOUNDATION S01°W 87.4' 15" W PINE S20°W 49.04' POWER POLE S80°W 107.71' SET CED POST W/LOC TAG BESIDE FD 1" GALV. PIPE SOUTH 33'

NO OTHER USEFULL WIT. IN AREA.

Signed by Carl F. Roser

Date 9-27-95

Surveyor's Michigan License No. 12028