SURVEY & REMONUMENTATION

MAR 02 2001

LAND CORNER RECORDATION CERTIFICATE Filing Requirement of Act 74, Mich. P.A. 1970

SECTION

For comers in

Ontonagon County	Located	l in:		Comer Code #
Public Land Survey		T51N T T T	R38W R R R	D-7
Property Controlling in Section	S S	T T	R R	•
Miscellaneous Property in Sec.	Š S	Ť T	R R	


Recorded Plat

JUDITH D. ROEHM Ontonagon County LC 5/361 of JEM Date 01/03/2001 14:34:36 RECORDING FEE: 9 00


Register of Deeds Stamp & File Number

5. Private Claims

4. Lot No.

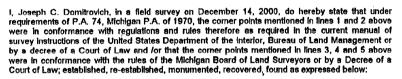

NOTE: Not more than 2 corners, all in the same town and range, may be recorded on this certificate.

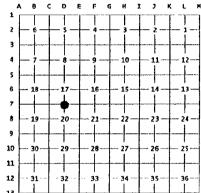

A. Description of original monument and accessories and/or subsequent restoration:

(D-7) 1/2 Corner common to Sections 17 and 20, T51N, R38W

1846- H. and S.W. Higgins set a 1/4 post 14" Sugar S 60°E 11 links 24" Hemlock N 30°W 6 links

I found no record of subsequent restoration.

B. Description of comer evidence found and/or method applied in restoring or reestablishing corner:

I found no remains of the original ¼ corner or accessories. The area of the corner now falls in an open pasture area. The property owner, Clarence Wilbur, owns the entire section to the North and South of this corner. Only containment fences are evident. I have concluded that this corner is lost and have reestablished it by single proportionate measurement.

Research on file with County Remonumentation Representative.

C. Description of monument for comer and accessories established to perpetuate locating the position of the corner:

Corner is a ¾" x 48" aluminum rod with a 3" diameter aluminum cap stamped to read: COUNTY REMONUMENTATION; T51N, R38W; ¼; S.17, S.20; 2000; P.S. 37273. Ties:

7" Hard Maple S 03°W 155.07 12" Hard Maple S 19°W 126.86 S 55°W 56.20' (angle in fence) Fence Post Steel Sign Rail North 0.32' (to face) S 87°56'39"E 2761 61 NE Cor. S. 20 NW Cor. S. 20 N 87°56'39"W

2761.61'

BF M/cr **IOSEPH** DOMETROVICE Nn. 37273

NOTE: Bearings to witness objects are magnetic. Distances are to a nail in side of the witness object unless noted. Bearings shown between corners are on assumed basis, for reference only.

Surveyor's Michigan License No. 37273