

SURVEY &  
REMONUMENTATION

APR 25 1995

LAND CORNER RECORDATION CERTIFICATE  
Filing Requirement of Act 74, Mich. P.A. 1970

For corners in COMMISSION  
Osceola  
(County)

Located In:

Corner Code #

1. Public Land Survey T 19N R 9W A-8  
T R  
T R  
T R
2. Property Controlling S T R  
in Section S T R
3. Miscellaneous S T R  
Property in Sec. S T R

APPROVED LAND CORNER  
P.A. 345 OF 1990  
Osceola County

*Matthew McClung*  
29 Nov. 1994

Register of Deeds Stamp & File Number

4. Lot No. , Recorded Plat  
5. Private Claims

I, Matthew McClung, in a field survey on November 28, 1994  
do hereby certify that under requirements of P.A. 74, Michigan P.A. of 1970, the corner points mentioned  
in lines 1 and 2 above were in conformance with regulations and rules therefore as required in the  
current manual of survey instructions of the United States Department of the Interior, Bureau of Land  
Management or by a decree of a Court of Law and/or that the corner points mentioned in lines 3, 4 and 5  
above were in conformance with the rules of the Michigan Board of Land Surveyors or by a Decree of a  
Court of Law; established, re-established, monumented, re-monumented, recovered, found as  
expressed below:

NOTE: Not more than 4 corners, all in the same town and range, may be recorded  
on this certificate.

A. Description of original monument and accessories and/or subsequent restoration:

The original corner was set by deputy surveyor Sylvester Sibley on July 7,  
1838. Set wood post 40.00 chains from the South.


Black Ash 6" S76W 14 lks.

Elm 16" N16W 20 lks.

From 1891 to 1904 approximately, Osceola County had a remonumentation  
program, in which surveyors Temple and Trumbull, did the work. For the  
most part, a 3" glazed tile filled with cinders from a forge, were placed  
at each government set corner in the township. There were supposed to be 3  
tile per corner, placed atop of each other, (continued on back)

B. Description of corner evidence found and/or method applied in restoring or reestablishing corner:

Found 1/2" rod with cap by James Ray in centerline of asphalt road. Set  
Osceola County Monument over 1/2" rod 1" below road surface. Corner is in  
east and west fences. Corner is in road fill 8 feet over original corner.

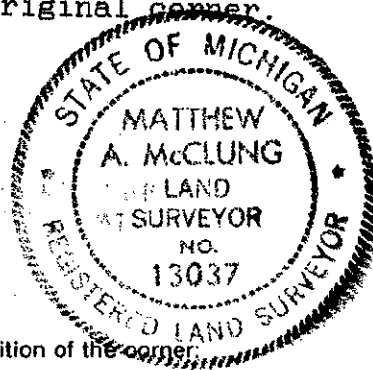

C. Description of monument for corner and accessories established to perpetuate locating the position of the corner:

Corner A-8. Osceola County Monument, which is a 3" brass cap mounted on a  
1" pipe 18" in length.

Power pole S10W 184.80 feet.

8" W. Ash S70E 54.70 feet.

16" Sugar Maple S15E 134.60 feet.

13" W. Ash S45E 89.45 feet.

30 DEC -1 LN 5:21

Signed by *Matthew McClung*  
Surveyor's Michigan License No. 13037

Date November 28, 1993

FORM APPROVED BY MICHIGAN STATE BOARD OF LAND SURVEYORS, JAN. 28, 1971  
REVISED MAY 14, 1975  
REVISED JAN., 1983

OSCEOLA COUNTY  
REGISTER OF DEEDS

94 DEC -7 PM 2:51

*Nancy Crawford*

thereby making the corner 4 feet long. Sometimes a solid tile, with a cross in the top was used, and sometimes a 1/2" iron bars were added to the tile. Notes of the work were kept in ledgers, and given to the townships, and 5 of the townships have been recorded in the County records.

RECORDED  
BY [illegible]  
[illegible]