

SURVEY &
REMONUMENTATION

FEB 16 1999

SECTION

LAND CORNER RECORDATION CERTIFICATE
Filing Requirement of Act 74, Mich. P.A. 1970

For corners in

Osceola

(County)

Located In:

Corner Code #

1. Public Land Survey

T20N R 7W

C-9

T R

T R

T R

2. Property Controlling
in Section

S

T R

S

T R

3. Miscellaneous

S

T R

Property in Sec.

S

T R

4. Lot No. _____, Recorded Plat _____

5. Private Claims _____

APPROVED LAND CORNER
P.A. 345 OF 1990
Osceola County

Matthew McClung
8 Oct 1998

Register of Deeds Stamp & File Number

I, Matthew McClung in a field survey on 6 23, 19 98 do hereby state that under requirements of P.A. 74, Michigan P.A. of 1970, the corner points mentioned in lines 1 and 2 above were in conformance with regulations and rules therefore as required in the current manual of survey instructions of the United States Department of the Interior, Bureau of Land Management or by a decree of a Court of Law and /or that the corner points mentioned in lines 3, 4 and 5 above were in conformance with the rules of the Michigan Board of Land Surveyors or by a Decree of a Court of Law; established, re-established, monumented, recovered, found as expressed below:

NOTE: Not more than 2 corners, all in the same town and range, may be recorded on this certificate.

	A	B	C	D	E	F	G	H	I	J	K	L	M
1													
2	6		5		4		3		2		1		
3													
4	7		8		9		10		11		12		
5													
6	16		17		18		19		20		21		
7													
8	19		20		21		22		23		24		
9													
10	30		29		28		27		26		25		
11													
12	31		32		33		34		35		36		
13													

A. Description of original monument and accessories and/or subsequent restoration:

The original corner was set by deputy surveyor Francis Coleman Sept. 27, 1856. Set Post 79.37 chains. from South.

Hemlock 14" N2E 45 lks.

Hemlock 16" S51W 39 lks

From 1891 to 1904 approximately, Osceola County had a remonumentation program, in which surveyors Temple and Trumbull, did the work. For the most part, a 3" glazed tile filled with cinders from a forge, were placed at each government set corner in the township. There were supposed to be 3 tile per corner, placed atop of each other, (continued on back)

B. Description of corner evidence found and/or method applied in restoring or reestablishing corner:

Found 1"x 1" Angle Iron in Monument Box. Corner is in centerline of East and West Road and 2 feet West of centerline in North and South Road.

C. Description of monument for corner and accessories established to perpetuate locating the position of the corner:

Corner C-9. Is a MSHD stake which is a 1" x 1" Angle Iron in a Monument Box.


Cut Off pole S40E 72.55 feet O.B.P.

5" Maple S50W 76.80 feet O.B.T.

R/W marker N21E 69.75 O.B.P.

Telephone Box N30E 76.5 feet. O.B.P.

24" Maple N30W 75.0 feet. O.B.T.

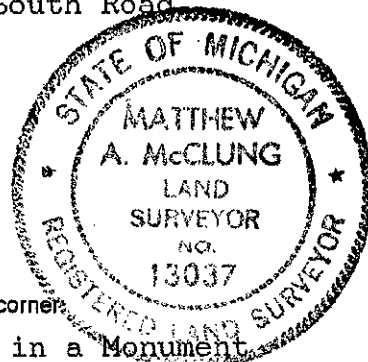

Signed by

Matthew McClung

13037

Date

23 Nov. 98

Surveyor's Michigan License No.

SURVEY &
REMONUMENTATION

FEB 16 1999

SECTION

OSCEOLA COUNTY
REGISTER OF DEEDS

98 NOV 23 AM 10:37

Nancy Crawford

thereby making the corner 4 feet long. Sometimes a solid tile, with a cross in the top was used, and sometimes a 1/2" iron bars were added to the tile. Notes of the work were kept in ledgers, and given to the townships, and 5 of the townships have been entered in the County Surveyors records.

Marion Township Book

Pages 68 and 69

1 = Tile

Post S52E 50 lks.

Maple 3" N17E 89.8'

Act 132 Liber 304, Page 203 & 204

Fd. Iron in M-61

RD R/W Marker N15E 69.80'

Telephone P. S45E 76.20'

Act 71 Liber 3, Page 46

Fd Angle Iron

Tel Pole S45E 72.6'

R/w Marker N15E 69.80'

Tel Box N40E 76.52'

3" Maple S50W 76.85'

Marion Township Book

Pages 28 and 29

Telephone Pole N52 1/2E 59 lks

Telephone Pole S63 1/2E 80 lks

Tile

Also

1=stake Maple NW 75'

Maple SW 66.4'

Pine SE 62'