

LAND CORNER RECORDATION CERTIFICATE  
Filing Requirement of Act 74, Mich. P.A. 1970

For corners in  
Oscoda

(County)

Located in:

Corner Code #

1. Public Land Survey

T 26N R 2E

B - 11

T R

T R

T R

2. Property Controlling  
in Section

S T R

S T R

3. Miscellaneous

S T R

Property in Section

S T R

4. Lot No. , Recorded Plat

5. Private Claims

Liber 4 pg. 73

STATE OF MICHIGAN  
OSCODA COUNTY  
FILED

2 AUG 95 9:38 A.M.

PATSY J. PETERS  
REGISTER OF DEEDS  
Register of Deeds Stamp & File Number

I, Marvin E. Myers, in a field survey on June 5, 19 95,  
do hereby certify that under requirements of P.A. 74, Michigan P.A. of 1970, the corner points mentioned  
in lines 1 and 2 above were in conformance with regulations and rules therefore as required in the current  
manual of survey instructions of the United States Department of the Interior, Bureau of Land  
Management or by a decree of a Court of Law and/or that the corner points mentioned in lines 3, 4 and  
5 above were in conformance with the rules of the Michigan Board of Professional Surveyors or by a  
Decree of a Court of Law; established, re-established, monumented, re-monumented, recovered, found  
as expressed below:

NOTE: Not more than 4 corners, all in the same town and range, may be recorded  
on this certificate.

A. Description of original monument and accessories and/or subsequent restoration:

GLO-W. Coon July 1839

Mon-Post

WIT: 3" Spruce N71°W 18 lks.

6" Spruce S64°E 9 lks.

US GLO-G. Veal Oct. 1935

Mon-Set Conc. Mon. 3 1/2" Tablet

Set by proportionate Dist.

WIT: 7" J. Pine N06 1/2°E 26 lks.

7" J. Pine S58°W 29 lks.

LCRC L.3, pg.266

Gary Wilson Sept. 21, 1992

Mon-Fd. GLO Mon.

WIT: 1/2" Bar & Cap #25881 N40°E 75.00

1/2" Bar & Cap #25881 S45°E 75.00

1/2" Bar & Cap #25881 S30°E 80.00

1/2" Bar & Cap #25881 N50°W 100.00

B. Description of corner evidence found and/or method applied in restoring or reestablishing corner:

Found US GLO Monument. Accepted as a careful and faithful establishment of the position of the corner.

APPROVED

County Remonumentation  
Peer Review Group

NCC/31 AUG 95  
JULY

C. Description of monument for corner and accessories established to perpetuate locating the position of the corner:


Mon-US GLO Conc. Mon. with carsonite post along side

WIT: Fd. 1/2" Bar & Cap #25881 N40°E 75.00

Fd. 1/2" Bar & Cap #25831 S45°E 75.00

Fd. 1/2" Bar & Cap #25881 S30°E 80.00

Fd. 1/2" Bar & Cap #25881 N50°W 100.00

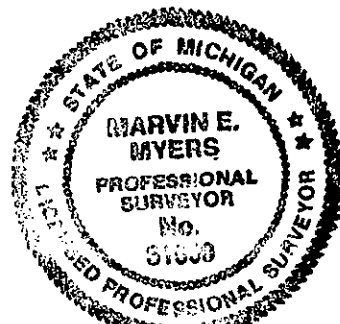

Signed by

*Marvin E. Myers*

Date

*July 28, 1995*

Surveyor's Michigan License No.

31600

FORM APPROVED BY MICHIGAN STATE BOARD OF PROFESSIONAL SURVEYORS, JAN. 28, 1971  
REVISED MAY 14, 1975  
REVISED JAN., 1983