

SEP 29 1994

**COMMISSION**

**LAND CORNER RECORDATION CERTIFICATE**  
**Filing Requirement of Act 74, Mich. P.A. 1970**

L-3 Pg 278

For corners in

Oscoda  
(County)

Located In:

Corner Code ##

- |                                    |                          |              |
|------------------------------------|--------------------------|--------------|
| 1. Public Land Survey              | T <u>26N</u> R <u>2E</u> | <u>D - 3</u> |
|                                    | T _____ R _____          | _____        |
|                                    | T _____ R _____          | _____        |
|                                    | T _____ R _____          | _____        |
| 2. Property Controlling in Section | S _____ T _____ R _____  | _____        |
|                                    | S _____ T _____ R _____  | _____        |
| 3. Miscellaneous Property in Sec.  | S _____ T _____ R _____  | _____        |
|                                    | S _____ T _____ R _____  | _____        |

STATE OF MICHIGAN  
OSCODA COUNTY  
FILED

14 SEP 94 11:07 A.M.

PATSY J. PETERS  
REGISTER OF DEEDS

Register of Deeds Stamp & File Number

4. Lot No. \_\_\_\_\_, Recorded Plat \_\_\_\_\_
5. Private Claims \_\_\_\_\_

	A	B	C	D	E	F	G	H	I	J	K	L	M
2	6		5		4		3		2		1		
3													
4	7		8		9		10		11		12		
5													
6	18		17		16		15		14		13		
7													
8	19		20		21		22		23		24		
9													
10	30		29		28		27		26		25		
11													
12	31		32		33		34		35		36		
13													

I, Marvin E. Myers, in a field survey on July 12, 19 94, do hereby certify that under requirements of P.A. 74, Michigan P.A. of 1970, the corner points mentioned in lines 1 and 2 above were in conformance with regulations and rules therefore as required in the current manual of survey instructions of the United States Department of the Interior, Bureau of Land Management or by a decree of a Court of Law and/or that the corner points mentioned in lines 3, 4 and 5 above were in conformance with the rules of the Michigan Board of Land Surveyors or by a Decree of a Court of Law; established, re-established, monumented, re-monumented, recovered, found as expressed below:

**NOTE: Not more than 4 corners, all in the same town and range, may be recorded on this certificate.**

**A. Description of original monument and accessories and/or subsequent restoration:**

GLO-July 1839 Coon  
Mon-Post  
WIT: 4" Spruce S62°E 24 lks.  
6" Spruce N57°N 21 lks.

Dec. 1890 Randall  
Mon-Post  
WIT: 30" W.P. Stump N41°W 98 lks.

1908-1909 Fargo, Eng. (C.P.CO.)  
Mon-  
WIT: 30" W.Pine Stump N41°W 98 lks.  
30" W.Pine Stump S67°W 60½ lks.

Feb. 1924 G.F.Delamater  
GLO-1935 Guy Veal  
Mon-3½" Brass Tablet in 6" Conc. Mon.  
WIT: 8" Norway East 37 lks.  
6" Balsam N40½°E 38½ lks.  
9" Poplar S79°E 5½ lks.  
Wood Post N17½°W 121 lks.

May 8, 1940 G.D.Henning  
Mon-GLO Mon. Fd.  
July 1955 G.D.Henning  
Mon-US GLO Mon.  
WIT: ½"x36" Iron Bar N89°06'E 332.90'  
on section line  
½" Iron Bar N00°58'W 654.80'  
On 1/4 line

L.I., pg.180 Feb. 14, 1972 N.Caldwell  
Mon-US GLO Mon.  
WIT: 14" Norway N80°E 22.50'  
10" Norway S50°E 43.60'  
Poplar Stump S79°E 3.60'

Sept. 1979 Consumers Power File  
Mon-Fd. GLO Mon.  
WIT: 12" R.Pine N86°W 38.39'  
18" R.Pine N75°E 22.55'  
14" R.Pine S45°E 43.80'  
14" Maple N21°E 19.32'

Consumers Power Co. Files  
Mon-Wood Stake  
WIT: 15" W.Pine S67½°W  
8" Y.Pine East 24.00'


**APPROVED**  
County Remonumentation  
Peer Review Group

NCL  
27 AUG 94

**B. Description of corner evidence found and/or method applied in restoring or reestablishing corner.**  
Veal did not accept the Fargo/Randall/Delamater monument.  
Found US GLO 6" Concrete Monument with 3½" Dia. Brass Tablet. Verified position by measurement to accessories of record and is accepted as a careful and faithful reestablishment of the position of the original corner.

**C. Description of monument for corner and accessories established to perpetuate locating the position of the corner:**

Mon-US GLO 6" Dia. Concrete Monument with Std. 3½" Brass Tablet  
WIT: Fd. USFS location Post N49°E 1'±  
Fd. 18" R.Pine (now 19") N80°E to blaze 22.50'  
C E-W Trail-Road South 30'±  
Fd. 14" R.Pine (now 16") S43°E 43.80'  
Fd. 15" W.Pine (now 29") Set 4" Polebarn Nail in N. side S85°W 39.80'  
Set 4" Polebarn Nail in NW side 4" W.Pine N22°E 14.66'  
Set 4" Polebarn Nail in W. side 5" W.Pine N40°W 19.72'

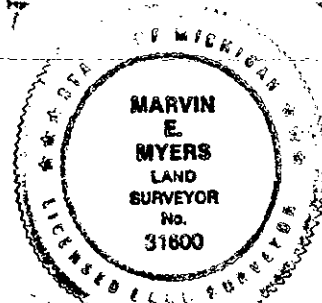

Signed by

*Marvin E. Myers*

Date

AUG 23, 1994

Surveyor's Michigan License No. 31600