

LAND CORNER RECORDATION CERTIFICATE  
Filing Requirement of Act 74, Mich. P.A. 1970

LIBER 3  
PAGE 11

For corners in

Oscoda  
(County)

Located In:

Corner Code: 11

1. Public Land Survey

T27N R 1E

B-11

T R

T R

T R

2. Property Controlling  
in Section

S T R

S T R

3. Miscellaneous  
Property in Sec.

S T R

S T R

At 11/13

A

Date

June 90

PATRICIA VANCE

Register of Deeds

Oscoda County, Michigan

Register of Deeds Stamp & File Number

1. Lot No. Recorded Plat

2. Private Claims

Norman C. Caldwell

in a field survey on March 19 90

to hereby certify that under requirements of P.A. 74, Michigan P.A. of 1970, the corner points mentioned in lines 1 and 2 above were in conformance with regulations and rules therefore as required in the current manual of survey instructions of the United States Department of the Interior, Bureau of Land Management or by a decree of a Court of Law and/or that the corner points mentioned in lines 3, 4 and 5 above were in conformance with the rules of the Michigan Board of Land Surveyors or by a Decree of a Court of Law; established, re-established, monumented, re-monumented, recovered, found as expressed below:

NOTE: Not more than 4 corners, all in the same town and range, may be recorded on this certificate.

1. Description of original monument and accessories and/or subsequent restoration:

(B-11) Post set by Coon, Dec. 13, 1839.  
Cedar 6" S70°E .12 (7.92')  
Tamarack 8" N64°W .15 (9.90')

2. Description of corner evidence found and/or method applied in restoring or reestablishing corner:

(B-11) DNR pipe & post placed by a single proportion, K.J. Ostling, LS 10068,  
April 19, 1977.  
N20°W 49.8' 12" R. Pine  
East 44.95' 7" R. Pine


3. Description of monument for corner and accessories established to perpetuate locating the position of the corner:

(B-11) 1/4 cor. Sec. 30&31, T27N-R1E

Fnd. DNR pipe & cap, no evidence of orig.  
cor. Accepted as a careful & faithful reestablishment of the position of the orig. cor.  
South 0.5' Carsonite Witness Post North 1.5' Red Top Post  
N20°W 50.4' 16" R. Pine (R)  
N55°W 59.4' 16" R. Pine  
S65°W 35.5' 8" R. Pine  
N89°E 45.5' 14" R. Pine (R)

igned by

Surveyor's Michigan License No. 12018

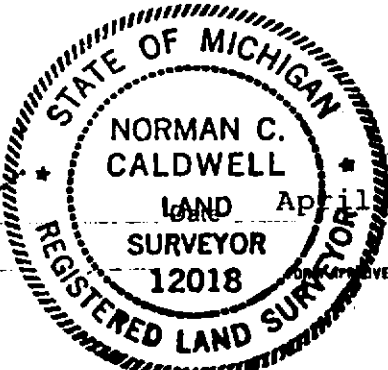

	A	B	C	D	E	F	G	H	I	J	K	L	M
2	6	5	4	3	2	1							
3													
4	7	8	9	10	11	12							
5													
6	18	17	16	15	14	13							
7													
8	19	20	21	22	23	24							
9													
10	30	29	28	27	26	25							
11													
12	31	32	33	34	35	36							
13													