

# LAND CORNER RECORDATION CERTIFICATE

FILING REQUIREMENT OF ACT 74, MICH. P.A.1970

FOR CORNERS OF--	LOCATED IN--	CORNER CODE NUMBER
1. PUBLIC LAND SURVEY	T. 31 N. R. 1 W.	D-11;
2. PROPERTY CONTROLLING IN SECTION	29 T. 31 N. R. 1 W.	5; 12; 15; 10
3. MISCELLANEOUS PROPERTY IN SECTION	T. N. R. E. S. R. W.	
4. LOT NO.	RECORDED PLAT	
5. PRIVATE CLAIMS		

REGISTER OF DEEDS STAMP AND FILING NUMBER

I, Kenneth J. Ostling, do hereby certify that under requirements of P.A. 74, Michigan P.A. of 1970, the corner points mentioned in lines 1 and 2 above were, in a field survey on November 10, 1980, established, re-established, monumented, re-monumented, recovered or restored as expressed below and in conformance with regulations and rules therefore as required in the current manual of survey instructions of the United States Department of the Interior, Bureau of Land Management or by a decree of a court of law. Furthermore, that the corner points mentioned in lines 3, 4 and 5 above were, in a field survey on \_\_\_\_\_, 19\_\_\_\_, found, recovered, restored, established or re-established as expressed below and in conformance with the rules of the Michigan State Board of Registration for Land Surveyors or, by a Decree of a Court of law:

XX

## C. Continued:

5	12	10
Set 5/8" rod w/RLS cap	Set 5/8" rod w/RLS cap	Set 5/8" rod w/RLS cap
6" Cedar S10°E 9.7'	10" Maple N71°W 25.6'	6" Balsam N29°E 8.95'
5" Cedar S61°W 6.6'	9" Maple N79°E 57.1'	3" Spruce S60°E 2.40'

## B. Description of corner evidence found and/or method applied in restoring or re-establishing corner:

D-11 Fd. 1/2" iron rod 18" below surface from G. F. Delamater records, and witness monument.

5 Set corner by standard survey procedure for the subdivision of sections.

12 Set by standard survey procedure for the subdivision of sections.

15 Set corner by standard survey procedure for the subdivision of sections.

10 Set by standard survey procedure for the subdivision of sections.


## C. Description of monument for corner and accessories established to perpetuate locating the position of the corner:

D-11	15
Fd. 1/2" rod set DNR mon.	Set 5/8" rod w/RLS cap
Nail in 4" Jack Pine N19°W 60.81'	Nail in 8" Maple N19°W 60.81'
Nail in 5" Willow N68°E 75.65'	Nail in 8" Maple N52°E 59.59'
	Cedar post North 42'

SIGNED BY Kenneth J. Ostling

SURVEYOR'S MICHIGAN REGISTRATION NO. 10068

DATE 3/12/81

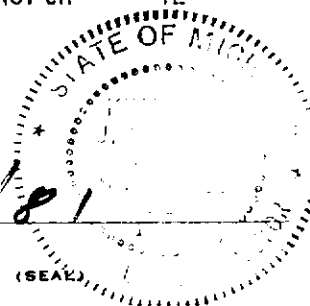

FOR STATE AND UNITED STATES AGENCIES:

SIGNED BY \_\_\_\_\_ DATE \_\_\_\_\_

CHIEF OF SURVEY PARTY

APPROVED AND SIGNED BY \_\_\_\_\_ DATE \_\_\_\_\_

MICHIGAN REGISTERED LAND SURVEYOR

SURVEYOR'S MICHIGAN REGISTRATION NO. \_\_\_\_\_ OTSEGO COUNTY