

SURVEY & REMONUMENTATION

APR 24 1995

OTTAWA COUNTY REMONUMENTATION

RECORDED

COMMISSION

LAND CORNER RECORDATION CERTIFICATE

94 DEC 14 AM 9:41

Filing Requirement of Act 74, Mich. P.A. 1970

For corners in OTTAWA

REGISTER OF DEEDS
OTTAWA COUNTY, MI

Located In: Corner Code #

1. Public Land Survey	T 5N R 15W	M-3 (SE cor of Sec. 1) Holland Twp.
	T R	
	T R	
	T R	
2. Property Controlling in Section	S T R	
	S T R	
3. Miscellaneous Property in Sec.	S T R	
	S T R	

4. Lot No. , Recorded Plat

5. Private Claims

Register of Deeds Stamp & File Number

	A	B	C	D	E	F	G	H	I	J	K	L	M
2	6	5	4	3	2	1							
3													
4	7	8	9	10	11	12							
5													
6	18	17	16	15	14	13							
7													
8	19	20	21	22	23	24							
9													
10	30	29	28	27	26	25							
11													
12	31	32	33	34	35	36							
13													

Randal J. Vugteveen in a field survey on November 21, 1994 do hereby certify that under requirements of P.A. 74, Michigan P.A. of 1970, the corner points mentioned in lines 1 and 2 above were in conformance with regulations and rules therefore as required in the current manual of survey instructions of the United States Department of the Interior, Bureau of Land Management or by a decree of a Court of Law and/or that the corner points mentioned in lines 3, 4 and 5 above were in conformance with the rules of the Michigan Board of Land Surveyors or by a Decree of a Court of Law; established, re-established, monumented, re-monumented, recovered, found as expressed below:

NOTE: Not more than 4 corners, all in the same town and range, may be recorded on this certificate.

A. Description of original monument and accessories and/or subsequent restoration:
M-3 common corner to Sections 1 & 12

1831 - Lyon & Sibley	Liber 2, Page 45	Liber 6, Page 5
Set post	Found 1/2" steel bar in centerline conc.	Set CIM
Beech 10" N131/4W 2 1/2 Links	P. Pole ENE 56.93'	Nail S side PP ENE 57.32'
Hemlock 10" S5W 24 Links	P. Pole NE 99.95'	Nail SE side PP NE 100.25'
	T. Pole NW 60.67'	PK nail NE side TP NW 61.34'
	Centerline Street sign SW 56.66'	SW cor Sec. 6-5-14 S 90.42'
	Brass Plug S 90.45'	
	(Zeeland Twp. corner)	

3. Description of corner evidence found and/or method applied in restoring or reestablishing corner:
M-3 Found CIM at centerline "X" of 96th Street & Quincy Avenue to the West in mon box and accepted as a careful and faithful perpetuation of the position of the original corner


1/2" steel bar in centerline conc.	CIM
P. pole ENE 56.93'	Nail S side PP ENE 57.30'
P. pole NE 99.95'	Nail SE side PP NE 100.24'
T. pole NW 60.67'	PK nail NE side TP N40W 61.36'
Centerline Street Sign S32W 56.60'	SW cor Sec. 6-5-14 S 90.49'

P.A. 345 OTTAWA COUNTY
PEER APPROVED 12/12/94

Randal J. Vugteveen

C. Description of monument for corner and accessories established to perpetuate locating the position of the corner:
M-3 Cast iron Monument in mon box

Set Ottawa County Remon Tag & Nail in SE side P. pole N60E 57.30'
Set Ottawa County Remon Tag & Nail in SE side P. pole N32E 100.24'
Set Ottawa County Remon Tag & Nail in NE side 30" Maple N59W 101.97'
CIM in mon box South 90.49'
NW corner brick garage S30E 194.77'

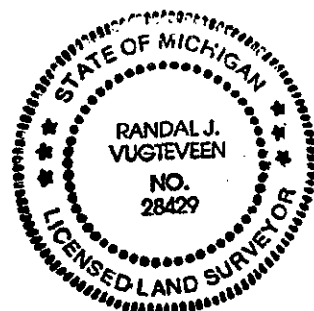

Signed by *Randal J. Vugteveen*
Surveyor's Michigan License No. 28429

Date Dec 12, 1994