

SURVEY & REMONUMENTATION

OTTAWA COUNTY REMONUMENTATION

APR 05 1996

LAND CORNER RECORDATION CERTIFICATE

Filing Requirement of Act 74, Mich. P.A. 1970

COMMISSION

For corners in
OTTAWA

(County)

Located In:

Corner Code #

1. Public Land Survey

T6N R13W

C-4 (E 1/4 cor
Section 7)

Georgetown Twp.

T R

T R

T R

2. Property Controlling
in Section

S T R

S T R

3. Miscellaneous
Property in Sec.

S T R

S T R

RECORDED

95 NOV 15 PM 2:10

Ruthie Kellman
REGISTER OF DEEDS
OTTAWA COUNTY, MI

Register of Deeds Stamp & File Number

4. Lot No. , Recorded Plat

5. Private Claims

I, Randal J. Vugteveen, in a field survey on October 10, 19 95, do hereby certify that under requirements of P.A. 74, Michigan P.A. of 1970, the corner points mentioned in lines 1 and 2 above were in conformance with regulations and rules therefore as required in the current manual of survey instructions of the United States Department of the Interior, Bureau of Land Management or by a decree of a Court of Law and/or that the corner points mentioned in lines 3, 4 and 5 above were in conformance with the rules of the Michigan Board of Land Surveyors or by a Decree of a Court of Law; established, re-established, monumented, re-monumented, recovered, found as expressed below:

NOTE: Not more than 4 corners, all in the same town and range, may be recorded on this certificate.

A. Description of original monument and accessories and/or subsequent restoration:

C-4 Common corner to Sections 7 & 8

1831 - Sibley

Set HMP

Sugar N80 E35 8 Links

W. Ash 582 W24 8 Links

Liber 5, Page 168

Set CIM

PP NNE 56.10'

PP ESE 101.91'

St. sign NW 43.85'

NW cor box culvert NE 48.10'

Liber 2, Page 575

Found Iron pipe, PK on top

PP NE 55.48'

PP ESE 101.18'

TP S 55.72'

B. Description of corner evidence found and/or method applied in restoring or reestablishing corner:

C-4 Found CIM in mon box 0.7' N of centerline Bauer Road & 2' W of centerline 40th Ave. and accepted as a careful and faithful perpetuation of the position of the original corner

Power Pole AZ. 31 deg 56.07'

Power Pole AZ. 108 deg 103.73'

Street sign AZ. 61 deg 48.09'

PAL 345 OTTAWA COUNTY

PEER APPROVED 10/23/95

C. Description of monument for corner and accessories established to perpetuate locating the position of the corner:


C-4 Cast Iron Monument in mon box

Set Ottawa County Remon Nail & Tag in E side p. pole AZ. 335 deg 55.07'

Set Ottawa County Remon Nail & Tag in W side p. pole AZ. 30 deg 56.06'

Set Ottawa County Remon Nail & Tag in N side p. pole AZ. 108 deg 103.81'

Set Ottawa County Remon Nail & Tag in W side 16" Elm Az. 177 deg 98.56'

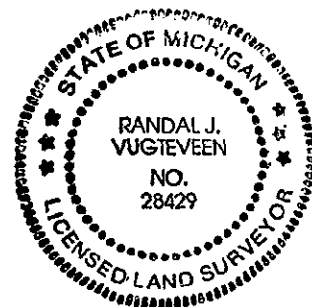

Signed by

Randal J. Vugteveen

Date OCT. 20, 1995

Surveyor's Michigan License No.

28429

FORM APPROVED BY MICHIGAN STATE BOARD OF LAND SURVEYORS, JAN. 28, 1971
REVISED MAY 14, 1971
REVISED JAN., 1991