

OTTAWA COUNTY REMONUMENTATION

RECORDED

LAND CORNER RECORDATION CERTIFICATE
Filing Requirement of Act 74, Mich. P.A. 1970

93 DEC 15 AM 9:26

For corners in **OTTAWA**

R. J. Vugteveen
REGISTER OF DEEDS
OTTAWA COUNTY, MI

	Located In:	Corner Code #
1. Public Land Survey	T 6N R 13W	C-7 (SE COR
	T R	Section 18)
	T R	Georgetown Twp
	T R	
2. Property Controlling	S T R	
in Section	S T R	
3. Miscellaneous	S T R	
Property in Sec.	S T R	

Register of Deeds Stamp & File Number

4. Lot No. _____, Recorded Plat _____
5. Private Claims _____

I, Randal J. Vugteveen, in a field survey on November 18, 1993, do hereby certify that under requirements of P.A. 74, Michigan P.A. of 1970, the corner points mentioned in lines 1 and 2 above were in conformance with regulations and rules therefore as required in the current manual of survey instructions of the United States Department of the Interior, Bureau of Land Management or by a decree of a Court of Law and/or that the corner points mentioned in lines 3, 4 and 5 above were in conformance with the rules of the Michigan Board of Land Surveyors or by a Decree of a Court of Law; established, re-established, monumented, re-monumented, recovered, found as expressed below:

NOTE: Not more than 4 corners, all in the same town and range, may be recorded on this certificate.

	A	B	C	D	E	F	G	H	I	J	K	L	M
2	1	2	3	4	5	6	7	8	9	10	11	12	13
3	14	15	16	17	18	19	20	21	22	23	24	25	26
4	27	28	29	30	31	32	33	34	35	36	37	38	39
5	40	41	42	43	44	45	46	47	48	49	50	51	52
6	53	54	55	56	57	58	59	60	61	62	63	64	65
7	66	67	68	69	70	71	72	73	74	75	76	77	78
8	79	80	81	82	83	84	85	86	87	88	89	90	91
9	92	93	94	95	96	97	98	99	100	101	102	103	104
10	105	106	107	108	109	110	111	112	113	114	115	116	117
11	118	119	120	121	122	123	124	125	126	127	128	129	130
12	131	132	133	134	135	136	137	138	139	140	141	142	143
13	144	145	146	147	148	149	150	151	152	153	154	155	156

A. Description of original monument and accessories and/or subsequent restoration:

C-7 LCRC Liber 1, Page 465	C-7 LCRC Liber 3, Page 82
5/8" Iron Pipe	Cast Iron Monument
Nail in face 12" Oak N50E 33.49'	Fire hyd. N45E 31.92'
Nail in face 24" Bas. E 34.24'	12" Oak N60E 34.14'
Nail in face 16" Pine S50E 95.06'	24" Bass. E 35.33'
E face MBT box W 34.08'	16" Pine S42E 96.67'
Plat monument W 33.00'	8" Oak S38W 56.09'
PK nail in side 8" Oak S65W 50.62'	Conc. Mon. W 33.00'


B. Description of corner evidence found and/or method applied in restoring or reestablishing corner:

C-7 Found CIM in mon box on centerline 40th and accepted as a careful and faithful perpetuation of the position of the original corner	C-7 Found CIM in mon box on centerline 40th and accepted as a careful and faithful perpetuation of the position of the original corner
Nail in face 16" Pine S50E 95.06'	Fire hydrant N45E 31.89'
E face MBT box W 33.47'	Find cut nail 16" Pine S42E 96.25'
PK nail in side 8" Oak S65W 50.62'	8" Oak S38W 56.09'

SURVEY & REMONUMENTATION
JAN 04 1994
COMMISSION

C. Description of monument for corner and accessories established to perpetuate locating the position of the corner:

C-7 Cast Iron Monument
Set Ottawa County Remon Tag & Nail in W side 24" White Pine S40E 96.28'
NE brk cor hse #7195 S67W 90.05'
SE foundation cor gar #7211 N86W 94.30
"T" Iron East 32.78'

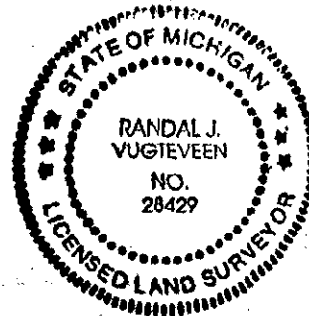

Signed by Randal J. Vugteveen
Surveyor's Michigan License No. 28429

Date Dec 6, 1993