

SURVEY &  
REMONUMENTATION

APR 24 1995

COMMISSION

OTTAWA COUNTY REMONUMENTATION

LAND CORNER RECORDATION CERTIFICATE

Filing Requirement of Act 74, Mich. P.A. 1970

RECORDED

94 DEC 14 AM 9:40

*Phyllis Sullivan*  
REGISTER OF DEEDS  
OTTAWA COUNTY, MI

For corners in OTTAWA

(County)

Located in:

Corner Code #

1. Public Land Survey

T 6N R 13W

C-10 (E 1/4 COR  
SECTION 30)  
Georgetown Twp.

2. Property Controlling  
in Section

S      T      R       
S      T      R     

3. Miscellaneous  
Property in Sec.

S      T      R       
S      T      R     

Register of Deeds Stamp & File Number

4. Lot No.           , Recorded Plat           

5. Private Claims           

	A	B	C	D	E	F	G	H	I	J	K	L	M
2	6		5		4		3		2		1		
3													
4	7		8		9		10		11		12		
5													
6	18		17		16		15		14		13		
7													
8	19		20		21		22		23		24		
9													
10	30		29		28		27		26		25		
11													
12	31		32		33		34		35		36		

I, Randal J. Vugteveen, in a field survey on December 6, 1994,  
do hereby certify that under requirements of P.A. 74, Michigan P.A. of 1970, the corner points mentioned  
in lines 1 and 2 above were in conformance with regulations and rules therefore as required in the  
current manual of survey instructions of the United States Department of the Interior, Bureau of Land  
Management or by a decree of a Court of Law and/or that the corner points mentioned in lines 3, 4 and 5  
above were in conformance with the rules of the Michigan Board of Land Surveyors or by a Decree of a  
Court of Law; established, re-established, monumented, re-monumented, recovered, found as  
expressed below:

**NOTE: Not more than 4 corners, all in the same town and range, may be recorded  
on this certificate.**

A. Description of original monument and accessories and/or subsequent restoration:  
C-10 Common corner to Sections 29 and 30

1831 - Lyon & Sibley  
Set H.M.P.  
Maple 10" S39E 6 Links  
B. Ash 7" S84W 90 Links

Liber 2, Page 817  
"T" Iron  
Nail in side P. pole ESE 52.58'  
PK in side P. pole SW 43.66'  
PK in NW end 96" CMP NNW 63.38'  
Centerline blacktop Road East

B. Description of corner evidence found and/or method applied in restoring or reestablishing corner:  
C-10 Found capped iron 17.3' West of centerline 40th Avenue and on centerline ditch E & W and accepted as a  
careful and faithful perpetuation of the position of the original corner  
Nail in side P. pole ESE 52.45'  
PK in side P. pole SW 43.10'  
Centerline blacktop Road East 17.3'


C. Description of monument for corner and accessories established to perpetuate locating the position of the corner:  
C-10 Removed iron set 3/4" X 36" solid bar with Ottawa County Remon Cap

AZ = Michigan State Grid Direction

Set Ottawa County Remon Tag & Nail in N side P. pole AZ. 113 deg 52.44'  
Set Ottawa County Remon Tag & Nail in SW side P. pole AZ. 141 deg 69.18'  
Set Ottawa County Remon Tag & Nail in NW side P. pole AZ. 223 deg 43.26'  
Centerline 40th Avenue AZ. 90 deg 17.3'

P.A. 345 OTTAWA COUNTY  
PEER APPROVED 12/12/94

*Arday D. Nedewell*

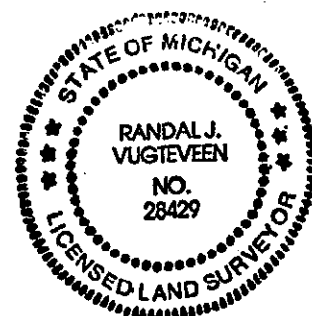

Signed by

*Randal J. Vugteveen*

Date

Dec 9, 1994

Surveyor's Michigan License No.

28429