

SURVEY &
REMONUMENTATION

FEB 27 1998

SECTION

OTTAWA COUNTY REMONUMENTATION
LAND CORNER RECORDATION CERTIFICATE
Filing Requirement of Act 74, Mich. P.A. 1970

RECORDED

97 DEC -8 AM 11:30

For corners in

OTTAWA

(County)

Located In:

Corner Code #

1. Public Land Survey

T6N R 13W

D-13, S 1/4

T R

corner, Sec. 32,

T R

Georgetown Twp.

T R

2. Property Controlling
in Section

S T R

S T R

3. Miscellaneous
Property in Sec.

S T R

S T R

Randy D. Vugteveen
REGISTER OF DEEDS
OTTAWA COUNTY, MI

Register of Deeds Stamp & File Number

4. Lot No. , Recorded Plat

5. Private Claims

I, Randal J. Vugteveen, in a field survey on November 17, 19 97 do hereby state that under requirements of P.A. 74, Michigan P.A. of 1970, the corner points mentioned in lines 1 and 2 above were in conformance with regulations and rules therefore as required in the current manual of survey instructions of the United States Department of the Interior, Bureau of Land Management or by a decree of a Court of Law and/or that the corner points mentioned in lines 3, 4 and 5 above were in conformance with the rules of the Michigan Board of Land Surveyors or by a Decree of a Court of Law; established, re-established, monumented, recovered, found as expressed below:

NOTE: Not more than 2 corners, all in the same town and range, may be recorded on this certificate.

	A	B	C	D	E	F	G	H	I	J	K	L	M
1													
2	6		5		4		3		2		1		
3													
4	7		8		9		10		11		12		
5													
6	18		17		16		15		14		13		
7													
8	19		20		21		22		23		24		
9													
10	30		29		28		27		26		25		
11													
12	31		32		33		34		35		36		
13													

A. Description of original monument and accessories and/or subsequent restoration:

D-13

G.L.O. survey notes

7" Sugar was corner

No witness set

L.C.R.C. Liber 2 Page 241 5/4/73

1/2" rod by previous witnesses

Nail in side guy pole NE 40.51'

Nail in side power pole NE 48.75'

NE corner house SW 92.43'

L.C.R.C. Liber 4 Page 5 11-16-79

Rerod

PK in guy pole NE 59.45'

PK in guy pole NW 59.02'

PK in power pole SSW 78.93'

North 1/4 corner Section 5, T5N, R13W East 12.55'

Face curb South 1.55'

B. Description of corner evidence found and/or method applied in restoring or reestablishing corner:

D-13 Found 5/8" rebar

NE corner house SW 92.42'

Found PK in guy pole NE 59.45'

Found PK in guy pole NW 59.25'

Found PK in guy power pole SSW 78.00'

North 1/4 corner Section 5, T5N, R13W 5/8" rebar

East 12.55'

Face concrete curb South 1.53'

Accepted position of 5/8" rebar as a careful
perpetuation of the position of the original corner

Removed rebar & set 3/4"x24" solid bar with Ottawa
County Remon Cap in monument box

P.A. 345 OTTAWA COUNTY
PEER APPROVED 12/1/97

C. Description of monument for corner and accessories established to perpetuate locating the position of the corner:

D-13

Ottawa County Remonumentation Iron and Cap in monument box

Set Ottawa County Remon tag & nail in SW side guy pole AZ 47° 59.22'

Set Ottawa County Remon tag & nail in SW side guy pole AZ 322° 58.95'

Set Ottawa County Remon tag & nail in East side power pole AZ 205° 78.58'

NW corner house #3582 AZ 128° 110.89'

North 1/4 corner Section 5, T5N, R13W 5/8" rebar East 12.55'

Face concrete curb South 1.53'


On centerline of road to North

Centerline of East-West road North 14'

Signed by Randal J. Vugteveen

Surveyor's Michigan License No. 28429

Date Dec. 1, 1997

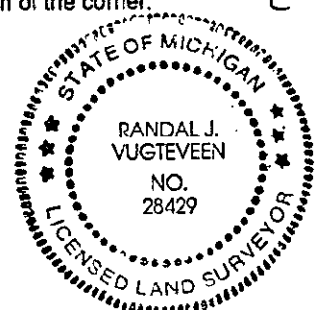

\$ 9.00
1.00 PHOTO
LIBRARY