

Ottawa County Remonumentation
LAND CORNER RECORDATION CERTIFICATE
Filing Requirement of Act 74, Mich. P.A. 1970

RECORDED

97 JUL 24 PM 2:26

For corners in

Ottawa

(County)

Located In:

Corner Code #

1. Public Land Survey

T 6N R 14W

B-13 (S 1/4, 31)

T R

Blendon Twp.

T R

T R

S T R

2. Property Controlling
in Section

S T R

S T R

3. Miscellaneous

S T R

Property in Sec.

S T R

4. Lot No. , Recorded Plat

5. Private Claims

Robert H. Blendon
REGISTER OF DEEDS
OTTAWA COUNTY, MI

Register of Deeds Stamp & File Number

I, John C. Bueche, in a field survey on October 17, 19 96, do hereby certify that under requirements of P.A. 74, Michigan P.A. of 1970, the corner points mentioned in lines 1 and 2 above were in conformance with regulations and rules therefore as required in the current manual of survey instructions of the United States Department of the Interior, Bureau of Land Management or by a decree of a Court of Law and/or that the corner points mentioned in lines 3, 4 and 5 above were in conformance with the rules of the Michigan Board of Land Surveyors or by a Decree of a Court of Law; established, re-established, monumented, re-monumented, recovered, found as expressed below:

NOTE: Not more than 4 corners, all in the same town and range, may be recorded on this certificate.

A. Description of original monument and accessories and/or subsequent restoration:

B-13 GLO	LCRC L1, P663	LCRC L4, P165
Lucius	1972 fnd. T iron	1981 set cast iron mon.
Lyon,	Fence line N.	6" Tree N 42.01'
DS, 1831	T iron Zeeland cor. W. 46.86'	10" Tree SE 89.41'
	SW cor. hse. #9175 NE 89.24'	2" steel post NW 41.98'
	SE cor. hse. #9175 NE 109.26'	Zeeland cor. W. 41.98'
	PP NE 124.58'	
	PP SE 90.93'	

B. Description of corner evidence found and/or method applied in restoring or reestablishing corner:

B-13 Found Ottawa Co. Mon. (4" Harrison) in gravel road, down 0.8'
As per above wit.

And is accepted as a careful and faithful perpetuation of the position of the original corner.

P.A. 345 OTTAWA COUNTY

PEER APPROVED 12-9-96

C. Description of monument for corner and accessories established to perpetuate locating the position of the corner:

B-13 Ottawa Co. Mon. (4" Harrison) in gravel road
Nail & Ottawa Co. Remon. Tag in S side PP N 70° W 126.56'
Nail & Ottawa Co. Remon. Tag in S side PP S 70° W 175.00'
Nail & Ottawa Co. Remon. Tag in E side dbl. 18" Ash S 35° W 88.94'
Nail & Ottawa Co. Remon. Tag in SE side 10" Ash S 50° E 33.85'
Nail & Ottawa Co. Remon. Tag in W side tri. 12" Ash N 05° E 41.93'
SW cor. of hse. N 40° E 89.07'
On C/L gravel road E-W, tree row South, West 50'±
Ottawa Co. Mon. (N 1/4 Sec. 6, 5-14) West 47.00'


Signed by

John C. Bueche, P.S. 13027

Date

11-7-96

Surveyor's Michigan License No.

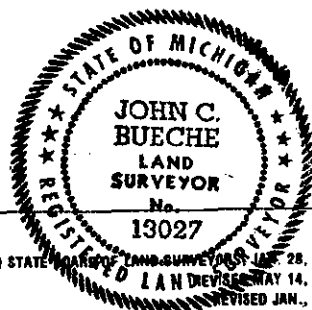

FORM APPROVED BY MICHIGAN STATE BOARD OF LAND SURVEYORS, JAN. 28, 1971
REVISED MAY 14, 1975
REVISED JAN., 1983