

SURVEY & REMONUMENTATION

OCT 24 1994

COMMISSION

OTTAWA COUNTY REMONUMENTATION LAND CORNER RECORDATION CERTIFICATE Filing Requirement of Act 74, Mich. P.A. 1970

RECORDED

94 OCT -7 PM 12:33

For corners in

Ottawa

(County)

Located In:

Corner Code ##

1. Public Land Survey T 6N R 14W E-5, SE COR
T _____ R _____ Sec. 8, Blendon
T _____ R _____
T _____ R _____
2. Property Controlling S _____ T _____ R _____
in Section S _____ T _____ R _____
3. Miscellaneous S _____ T _____ R _____
Property in Sec. S _____ T _____ R _____
4. Lot No. _____, Recorded Plat _____
5. Private Claims _____

Edythe L. Carlman
REGISTER OF DEEDS
OTTAWA COUNTY, MI

Register of Deeds Stamp & File Number

I, Randal D. Feenstra in a field survey on May 9, 19 94, do hereby certify that under requirements of P.A. 74, Michigan P.A. of 1970, the corner points mentioned in lines 1 and 2 above were in conformance with regulations and rules therefore as required in the current manual of survey instructions of the United States Department of the Interior, Bureau of Land Management or by a decree of a Court of Law and/or that the corner points mentioned in lines 3, 4 and 5 above were in conformance with the rules of the Michigan Board of Land Surveyors or by a Decree of a Court of Law; established, re-established, monumented, re-monumented, recovered, found as expressed below:

NOTE: Not more than 4 corners, all in the same town and range, may be recorded on this certificate.

A. Description of original monument and accessories and/or subsequent restoration:
G.L.O. (1932) L-2, Pg. 235 (1973) L-4, Pg. 169 (1981)

cor @ 6" Pepperage	Found Iron Pipe	Set Cast Iron Monument
POST	32" Maple NE 118.63	PP SW 70.26
	PP NW 89.67	PP NW 90.36
Samuel Marrs	St. Sign SE 31.72	PP NE 116.39
	PP SE 61.94	PP SE 62.26
	PP SW 69.74	

B. Description of corner evidence found and/or method applied in restoring or reestablishing corner:

Found Cast Iron Monument - accepted as a careful and faithful perpetuation of the position of the original corner.

Found Witnesses:


Nail & tag N side PP	S65°E 62.23
Nail & tag N side PP	S65°E 61.97
Nail N side PP	S65°E 61.92
Pk. nail E side PP	S35°W 67.17

P.A. 345 OTTAWA COUNTY
PEER APPROVED B/22/94

Edythe L. Carlman

C. Description of monument for corner and accessories established to perpetuate locating the position of the corner:

E-5 Cast Iron Mon.	
O.C. Remon. Nail & tag NW side PP	S35°W 66.99
O.C. Remon. Nail & tag S side PP	N75°E 116.20
O.C. Remon. Nail & tag N side PP	S65°E 62.22
O.C. Remon. Nail & tag E side PP	N30°W 92.35
CL of 80th and CL Polk	

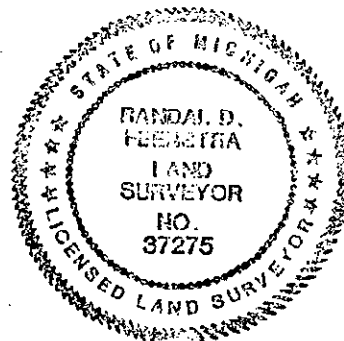

Signed by

Randal D. Feenstra

Date

May 9, 1994

Surveyor's Michigan License No. 37275

FORM APPROVED BY MICHIGAN STATE BOARD OF LAND SURVEYORS, JAN. 28, 1971
REVISED MAY 14, 1975
REVISED JAN., 1983