

FEB 18 1994

COMMISSION

OTTAWA COUNTY REMONUMENTATION  
LAND CORNER RECORDATION CERTIFICATE  
Filing Requirement of Act 74, Mich. P.A. 1970

RECORDED

93 NOV -8 PM 1:58

*Register of Deeds*  
REGISTER OF DEEDS  
OTTAWA COUNTY, MI

For corners in

Ottawa (County)	Located In:	Corner Code #
1. Public Land Survey	T <u>6N</u> R <u>14W</u>	F-9, S $\frac{1}{4}$ COR. Sec. 21, Blendon
	T <u>    </u> R <u>    </u>	
	T <u>    </u> R <u>    </u>	
	T <u>    </u> R <u>    </u>	
2. Property Controlling in Section	S <u>    </u> T <u>    </u> R <u>    </u>	
	S <u>    </u> T <u>    </u> R <u>    </u>	
3. Miscellaneous Property in Sec.	S <u>    </u> T <u>    </u> R <u>    </u>	
	S <u>    </u> T <u>    </u> R <u>    </u>	
4. Lot No. <u>          </u> , Recorded Plat <u>          </u>		
5. Private Claims <u>          </u>		

Register of Deeds Stamp & File Number

I, Randal D. Feenstra in a field survey on October 13, 19 93,  
do hereby certify that under requirements of P.A. 74, Michigan P.A. of 1970, the corner points mentioned  
in lines 1 and 2 above were in conformance with regulations and rules therefore as required in the  
current manual of survey instructions of the United States Department of the Interior, Bureau of Land  
Management or by a decree of a Court of Law and/or that the corner points mentioned in lines 3, 4 and 5  
above were in conformance with the rules of the Michigan Board of Land Surveyors or by a Decree of a  
Court of Law; established, re-established, monumented, re-monumented, recovered, found as  
expressed below:

NOTE: Not more than 4 corners, all in the same town and range, may be recorded  
on this certificate.

A. Description of original monument and accessories and/or subsequent restoration:

F-9:		
L.C.R.C.# L-5, P-124 (6-26-84)		L.C.R.C.# L-1, P-177 (11-11-71)
C.I. Monument		Steel Bar
P.Pole	NE 61.82	P.Pole
T. Pole	SE 42.56	P. Pole
10" Poplar	N 30.86	NW Cor. Gar.
CL Street sign	NW 34.05	E. edge conc culv W
		SE 112.51
		SE 42.15
		SE 61.53
		SE 34.55

B. Description of corner evidence found and/or method applied in restoring or reestablishing corner:


F-9: Found Cast Iron Monument in box, accepted as a careful and faithful perpetuation of the  
position of the original corner.

Nail & Tag in NW side P.P.	S45°E	42.24'
Nail & Tag in SW side P.P.	N30°E	61.57'
Nail in W. side P.P.	N30°E	61.85'

C. Description of monument for corner and accessories established to perpetuate locating the position of the corner:

F-9: Cast Iron Monument in Box		
O.C. Remon. Nail & Tag in W. side P.P.	S45°E	42.39'
O.C. Remon. Nail & Tag in N. side 6"x8" Guard Post	S60°W	44.42'
O.C. Remon. Nail & Tag in E. side 26" Poplar	N0°E	30.66'
O.C. Remon. Nail & Tag in W. side P.P.	N30°E	61.88'

15' West of CL "X" Port Sheldon & 76th Ave.

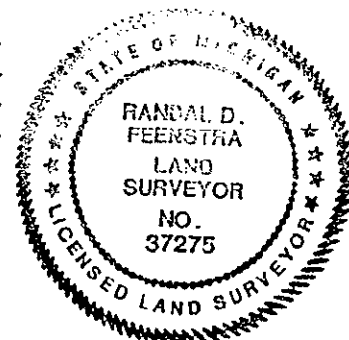

Signed by Randal D. Feenstra Date 10-18-93

Surveyor's Michigan License No. 37275