

SURVEY & REMONUMENTATION

NOV 10 1993

COMMISSION

LAND CORNER RECORDATION CERTIFICATE Filing Requirement of Act 74, Mich. P.A. 1970 OTTAWA COUNTY REMONUMENTATION

For corners in

OTTAWA
(County)

Located In:

Corner Code ##

BLENDOU TWP.

- | | | |
|-------------------------|---|--|
| 1. Public Land Survey | T <u>6N</u> R <u>14W</u> | <u>K-10, W$\frac{1}{4}$Cor-25</u> |
| | T <u> </u> R <u> </u> | <u> </u> |
| | T <u> </u> R <u> </u> | <u> </u> |
| | T <u> </u> R <u> </u> | <u> </u> |
| 2. Property Controlling | S <u> </u> T <u> </u> R <u> </u> | <u> </u> |
| in Section | S <u> </u> T <u> </u> R <u> </u> | <u> </u> |
| 3. Miscellaneous | S <u> </u> T <u> </u> R <u> </u> | <u> </u> |
| Property in Sec. | S <u> </u> T <u> </u> R <u> </u> | <u> </u> |

4. Lot No. , Recorded Plat
5. Private Claims

I, Randal D. Feenstra in a field survey on July 15, 19 93, do hereby certify that under requirements of P.A. 74, Michigan P.A. of 1970, the corner points mentioned in lines 1 and 2 above were in conformance with regulations and rules therefore as required in the current manual of survey instructions of the United States Department of the Interior, Bureau of Land Management or by a decree of a Court of Law and/or that the corner points mentioned in lines 3, 4 and 5 above were in conformance with the rules of the Michigan Board of Land Surveyors or by a Decree of a Court of Law; established, re-established, monumented, re-monumented, recovered, found as expressed below:

NOTE: Not more than 4 corners, all in the same town and range, may be recorded on this certificate.

- A. Description of original monument and accessories and/or subsequent restoration:
K-10 = LCRC#'s L-1, P-725; L-2, P-57; L-4, P-352

- B. Description of corner evidence found and/or method applied in restoring or reestablishing corner:

K-10

Found Cast Iron Monument
And Witnesses Per
LCRC # L-4, P-352

- C. Description of monument for corner and accessories established to perpetuate locating the position of the corner:

K-10-Cast Iron Monument per L-4, P-352, Ottawa County, MI, and is accepted as a careful and faithful perpetuation of the position of the original corner			
O.C. Remon. Nail & Tag in 45" Maple	S60°E	25.19	
O.C. Remon. Nail & Tag in 36" Maple	S75°W	23.06	
O.C. Remon. Nail & Tag in 32" Maple	S40°W	33.73	
O.C. Remon. Nail & Tag in 23" Maple	S20°W	69.45	
CL 56th 2' East	Fence line to West		


RECORDED

1993 SEP 29 PM 3:13

Randal D. Feenstra
REGISTER OF DEEDS
OTTAWA COUNTY, MI

Register of Deeds Stamp & File Number

	A	B	C	D	E	F	G	H	I	J	K	L	M
2	6	5	4	3	2	1							
3													
4	7	8	9	10	11	12							
5													
6	18	17	16	15	14	13							
7													
8	19	20	21	22	23	24							
9													
10	30	29	28	27	26	25							
11													
12	31	32	33	34	35	36							
13													

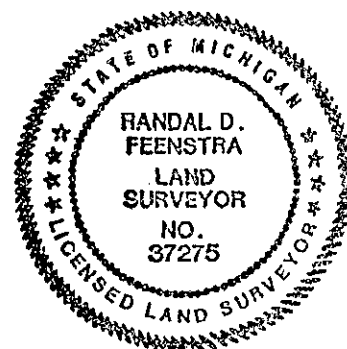

Signed by Randal D. Feenstra
Surveyor's Michigan License No. 37275

Date 7-15-93