

OTTAWA COUNTY REMONUMENTATION
LAND CORNER RECORDATION CERTIFICATE
Filing Requirement of Act 74, Mich. P.A. 1970

RECORDED

94 DEC -8 PM 12:36

For corners in

Richard R. Koning
REGISTER OF DEEDS
OTTAWA COUNTY, MI

Ottawa (County)	Located in:	Corner Code #
1. Public Land Survey	T 6N R 15W	E-8
	T R	(E 1/4 cor., Sec.
	T R	20, Olive Twp.)
	T R	
2. Property Controlling in Section	S T R	
	S T R	
3. Miscellaneous Property in Sec.	S T R	
	S T R	

Register of Deeds Stamp & File Number

4. Lot No. _____, Recorded Plat _____
5. Private Claims _____

Douglas J. Koning, In a field survey on August 17, 1994,
do hereby certify that under requirements of P.A. 74, Michigan P.A. of 1970, the corner points mentioned
in lines 1 and 2 above were in conformance with regulations and rules therefore as required in the
current manual of survey instructions of the United States Department of the Interior, Bureau of Land
Management or by a decree of a Court of Law and/or that the corner points mentioned in lines 3, 4 and 5
above were in conformance with the rules of the Michigan Board of Land Surveyors or by a Decree of a
Court of Law; established, re-established, monumented, re-monumented, recovered, found as
expressed below:

NOTE: Not more than 4 corners, all in the same town and range, may be recorded
on this certificate.

	A	B	C	D	E	F	G	H	I	J	K	L	M
2	6	5	4	3	2	1							
3													
4	7	8	9	10	11	12							
5													
6	18	17	16	15	14	13							
7													
8	19	20	21	22	23	24							
9													
10	30	29	28	27	26	25							
11													
12	31	32	33	34	35	36							
13													

A. Description of original monument and accessories and/of subsequent restoration:

E-8 Government Notes Set Post May 1832 By Calvin Britain D.S. Elm 12" S15°E 22 Links Maple 18" N15°W 25 Links	L.C.R.C. Liber 1, Page 781, December 1972 E-8 Found axle over stone "X" in culvert SE 28.84' "X" in culvert NE 21.62' "X" in culvert NW 26.00' Tel. Pole SW 47.94' Street Sign SW 38.03'	L.C.R.C. Liber 2, Page 371, November 1873 E-8 Found cross on stone with iron above Street Sign SW 38.2' "X" in culvert NE 21.81' "X" in culvert SE 28.81' "X" in culvert NW 26.11'
---	--	---

L.C.R.C. Liber 3, Page 385, July 1979
E-8 Cast Iron Monument
SW Street Sign 37.9'
NE "X" on Culvert 21.81'
SE "X" on Culvert 28.81'
NW "X" on Culvert 26.11'

B. Description of corner evidence found and/or method applied in restoring or reestablishing corner.

E-8 Found Cast Iron Monument
Found "X" Cut on Conc. Culvert N40°E 21.90'
Found "X" Cut on Conc. Culvert N45°W 26.12'
Found "X" Cut on Conc. Culvert S45°E 28.88'


P.A. 345 OTTAWA COUNTY
PEER APPROVED 11/21/94

Richard D. McDowell

This marker is accepted as a careful and faithful perpetuation of the original corner.

C. Description of monument for corner and accessories established to perpetuate locating the position of the corner.

E-8 Cast Iron Monument (6' N of centerline "X" of crossroads)
O.C. Remon Tag & Nail S Side Pwr Pole N82°E 92.53'
O.C. Remon Tag & Nail SW Side Pwr Pole N58°W 148.34'
"X" Cut on Conc. Culvert N40°E 21.90'
"X" Cut on Conc. Culvert N45°W 26.12'
"X" Cut on Conc. Culvert S45°E 28.88'

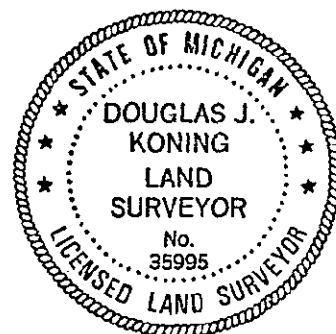

Signed by Douglas J. Koning
Surveyor's Michigan License No. 35995

Date November 14, 1994