

SURVEY & REMONUMENTATION

JUN 28 1999

SECTION

OTTAWA COUNTY REMONUMENTATION LAND CORNER RECORDATION CERTIFICATE

RECORDED

98 NOV -4 PM 2:31

Sam R. R. R.
REGISTER OF DEEDS
OTTAWA COUNTY, MI

For corners in

Filing Requirement of Act 74, Mich. P.A. 1970

Ottawa (County)	Located in:	Corner Code #
1. Public Land Survey	T 6N R15W	G-1
	T R	(NE cor., Sec. 3 4
	T R	Olive Twp.)
	T R	
2. Property Controlling in Section	S T R	
	S T R	
3. Miscellaneous Property in Sec.	S T R	
	S T R	
4. Lot No. _____, Recorded Plat _____		
5. Private Claims _____		

Register of Deeds Stamp & File Number

I, Douglas J. Koning, in a field survey on October, 19 98, do hereby certify that under requirements of P.A. 74, Michigan P.A. of 1970, the corner points mentioned in lines 1 and 2 above were in conformance with regulations and rules therefore as required in the current manual of survey instructions of the United States Department of the Interior, Bureau of Land Management or by a decree of a Court of Law and/or that the corner points mentioned in lines 3, 4 and 5 above were in conformance with the rules of the Michigan Board of Land Surveyors or by a Decree of a Court of Law; established, re-established, monumented, re-monumented, recovered, found as expressed below:

NOTE: Not more than 4 corners, all in the same town and range, may be recorded on this certificate.

	A	B	C	D	E	F	G	H	I	J	K	L	M
2	6	5	4	3	2	1							
3													
4	7	8	9	10	11	12							
5													
6	18	17	16	15	14	13							
7													
8	19	20	21	22	23	24							
9													
10	30	29	28	27	26	25							
11													
12	31	32	33	34	35	36							
13													

A. Description of original monument and accessories and/or subsequent restoration:

G-1 Government Notes Set Post May 1832 1.05CH West of Post By Calvin Britain D.S. Pine 12" N58°E 5.46 Links Leo 10" N71°W 2.50 Links	L.C.R.C. Liber 1, Page 137, November 1971 G-1 Robinson corner if East 69.28' Centerline of 120th Avenue is East 95' Nail in face of 10" Pine NE 22.88' Nail in face of 28" Oak NW 39.40' Nail in face of 28" Oak SW 47.09' Nail in face of Power Pole SE 85.53'	L.C.R.C. Liber 6, Page 146, June 1991 G-1 Found Raised C.I.M. 30" Oak NW 31.03' 12" Oak SW 56.39' Power Pole SE 88.35' Robinson Corner E 69.31'
	L.C.R.C. Liber 1, Page 313, April 1972 G-1 Found O.C.R.C. Monument 10" Pine NE 22.88' 14" Oak SSW 47.10' 28" Oak NW 39.41' Centerline 120th Avenue e 95.2'	L.C.R.C. Liber 6, Page 131, May 1991 G-1 Reset Cast Monument E 69.30' to Robinson Corner NE 77.90' PK Nail E side Multiple Maple SE 87.58' PK Nail E side 12" Oak SW 56.37' PK Nail SW side 14" Oak NW 41.00' Nail SW side 36" Oak E 95.2 Centerline 120th Avenue

B. Description of corner evidence found and/or method applied in restoring or reestablishing corner.

G-1 Cast Iron Monument in Box (0.21' North of Township line)
Found PK Nail East side Multi Maple
Found Ottawa County Remon Cap and Iron (G-13, T7N, R15W)
Found Nail SE side 12" Oak

N15°E 77.90'
N90°E 69.32'
S55°W 56.39'

This marker is accepted as a careful and faithful perpetuation of the original corner.

C. Description of monument for corner and accessories established to perpetuate locating the position of the corner.

G-1 Cast Iron Monument 0.21' North of Township line in Monument Box
Monument is 1'± North and 90'± West of centerline "x" of Roads
Ottawa County Remon Cap & Iron in Monument Box (G-13, T7N, R15W)
Set Remon Tag & Nail SE side of Multi Maple (5)
Set Remon Tag & Nail in SW side 30" Oak
Set Remon Tag & Nail in SE side 10" Oak
Set Remon Tag & Nail in SW side Power Pole

East 69.32'
N15°E 77.44'
N50°W 40.59'
S55°W 56.56'
S50°E 86.71'


\$11.00 CORNER
Receipt #18213
\$2.00 PHOTO
Receipt #18213

Signed by

Surveyor's Michigan License No.

35995

LIBER 004 PAGE 234

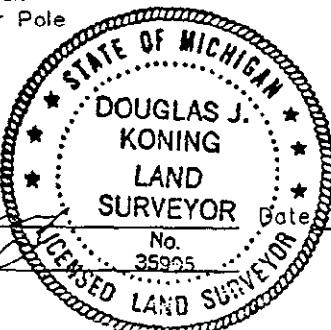

Date

10-19-98

RECEIVED APPROVED 10/19/98
(see sketch on back)


SURVEY &
REMONUMENTATION

JUN 28 1999

SECTION

SECTION 4, 16N, R15W
OLIVE TOWNSHIP,

SECTION 33, 17N, R15W
ROBINSON TOWNSHIP

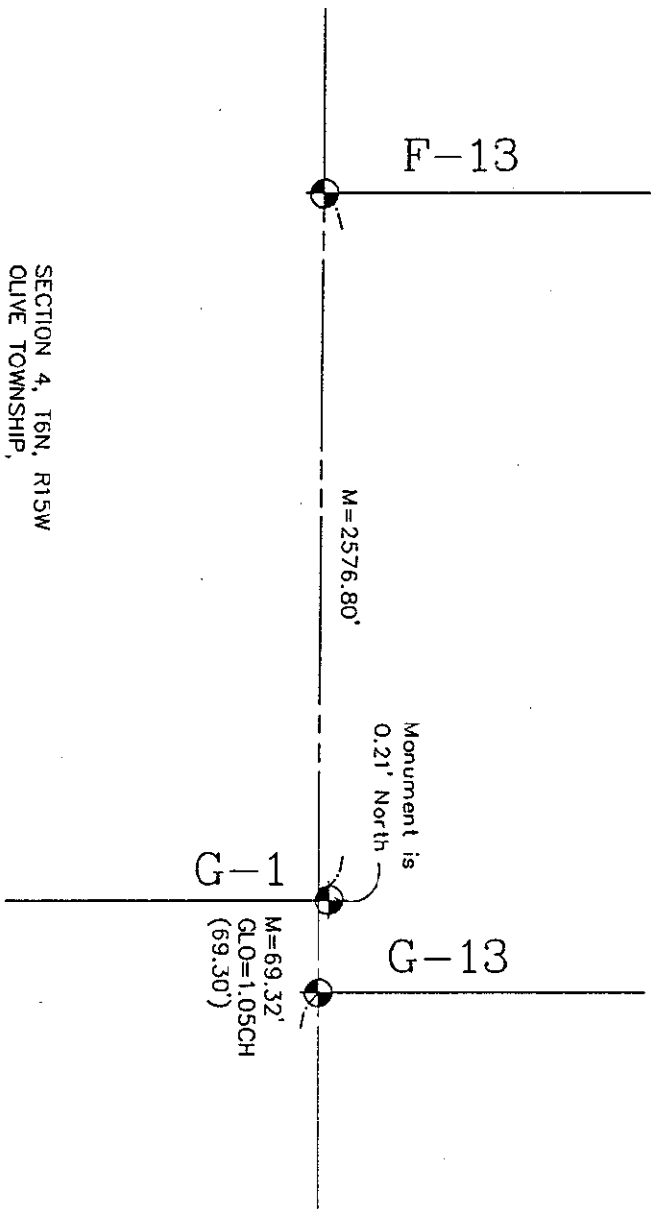

NO SCALE