

APR 05 1996

COMMISSION

OTTAWA COUNTY REMONUMENTATION
LAND CORNER RECORDATION CERTIFICATE

Filing Requirement of Act 74, Mich. P.A. 1970

RECORDED

95 DEC 12 PM 4:52

Douglas J. Koning
REGISTER OF DEEDS
OTTAWA COUNTY, MI

For corners in

Ottawa (County)	Located in:	Corner Code #
1. Public Land Survey	T 6N R15W	J-11
	T R	(S 1/4 cor., Sec. 26
	T R	Olive Twp.)
	T R	
2. Property Controlling in Section	S T R	
	S T R	
3. Miscellaneous Property In Sec.	S T R	
	S T R	
4. Lot No. _____, Recorded Plat _____		
5. Private Claims _____		

Register of Deeds Stamp & File Number

I, Douglas J. Koning, in a field survey on December 7, 1995, do hereby certify that under requirements of P.A. 74, Michigan P.A. of 1970, the corner points mentioned in lines 1 and 2 above were in conformance with regulations and rules therefore as required in the current manual of survey instructions of the United States Department of the Interior, Bureau of Land Management or by a decree of a Court of Law and/or that the corner points mentioned in lines 3, 4 and 5 above were in conformance with the rules of the Michigan Board of Land Surveyors or by a Decree of a Court of Law; established, re-established, monumented, re-monumented, recovered, found as expressed below:

NOTE: Not more than 4 corners, all in the same town and range, may be recorded on this certificate.

	A	B	C	D	E	F	G	H	I	J	K	L	M
2	6	5	4	3	2	1							
3													
4	7	8	9	10	11	12							
5													
6	18	17	16	15	14	13							
7													
8	19	20	21	22	23	24							
9													
10	30	29	28	27	26	25							
11													
12	31	32	33	34	35	36							
13													

A. Description of original monument and accessories and/of subsequent restoration:

J-11 Government Notes	L.C.R.C. Liber 2, Page 225 June 1973
Set Post May 1832	J-11 Found Iron Pipe, Set Cast Iron Monument
Maple 15" S66°W 2.25 Links	Telephone Pole NW 49.31'
No other near	Telephone Pole SW 44.40'
Calvin Britain D.S.	Guy Pole SW 62.02'
	Power Pole SE 65.70'
	Centerline Street Sign SW 42.08'

B. Description of corner evidence found and/or method applied in restoring or reestablishing corner.

J-11 Found Cast Iron Monument	
Found Nail & Tag in NE face Telephone Pole stump	SW 44.35'
Found Nail & Tag in N Guy Pole	SSW 61.95'
Found Nail & Tag in N Power Pole	SE 65.73'


P.A. 345 OTTAWA COUNTY
PEER APPROVED 12/11/95

Douglas J. Koning
MDN

This marker is accepted as a careful and faithful perpetuation of the original corner.

C. Description of monument for corner and accessories established to perpetuate locating the position of the corner.

J-11 Cast Iron Monument (6' E of Centerline "X" of Roads)	
Set Remon Tag & Nail in SE side Telephone Pole Stump	S55°W 44.57'
Set Remon Tag & Nail in E side Guy Pole	S30°W 62.27'
Set Remon Tag & Nail in W side Power Pole	S25°E 66.02'
Set Remon Tag & Nail in W side Power Pole	N7°E 249.01'

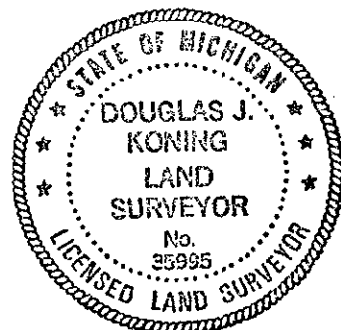

Signed by Douglas J. Koning
Surveyor's Michigan License No. 35995

Date 12-11-95