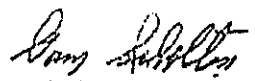


FEB 24 2000

RECORDED

99 SEP 23 PM 3:21

SECTION

OTTAWA COUNTY REMONUMENTATION
LAND CORNER RECORDATION CERTIFICATE

 REGISTER OF DEEDS
 OTTAWA COUNTY, MI

For corners in

Filing Requirement of Act 74, Mich. P.A. 1970

<u>Ottawa</u> (County)	Located in:	Corner Code #
1. Public Land Survey	T 6N R15W	L-1
	T R	(N 1/4 cor., Sec. 1
	T R	Olive Twp.)
	T R	
2. Property Controlling in Section	S T R	
	S T R	
3. Miscellaneous Property in Sec.	S T R	
	S T R	
4. Lot No. _____, Recorded Plot _____		
5. Private Claims _____		

Register of Deeds Stamp & File Number

I, Douglas J. Koning, in a field survey on September 3, 1999, do hereby certify that under requirements of P.A. 74, Michigan P.A. of 1970, the corner points mentioned in lines 1 and 2 above were in conformance with regulations and rules therefore as required in the current manual of survey instructions of the United States Department of the Interior, Bureau of Land Management or by a decree of a Court of Law and/or that the corner points mentioned in lines 3, 4 and 5 above were in conformance with the rules of the Michigan Board of Land Surveyors or by a Decree of a Court of Law; established, re-established, monumented, re-monumented, recovered, found as expressed below:

NOTE: Not more than 4 corners, all in the same town and range, may be recorded on this certificate.

	A	B	C	D	E	F	G	H	I	J	K
2	6	5	4	3	2	1					
3											
4	7	8	9	10	11	12					
5											
6	18	17	16	15	14	13					
7											
8	19	20	21	22	23	24					
9											
10	30	29	28	27	26	25					
11											
12	31	32	33	34	35	36					
13											

A. Description of original monument and accessories and/or subsequent restoration:

L-1 Government Notes Did Not Set	L.C.R.C. Liber 1, Page 575, August 1972, (J. Clapp) L-1 Found Iron 8" Pine NW 38.47' 24" Ash NE 49.29' 10" Oak SE 40.30' 20" Maple SW 83.98'	L.C.R.C. Liber 3, Page 205, November 1977 (W. Byl) L-1 Cast Iron Monument 8" Pine NW 39.01' 24" Pepperidge NE 50.25' Twin 12" Oak SE 42.05'
-------------------------------------	--	--

L.C.R.C. Liber 5, Page 339

November 1988 (M. Rosema)

L-1 Cast Iron Monument

Nail & Tag in SW side 12" Pine NW 39.01'

Nail in face twin 15" Oak SE 39.85'

Nail in W side Cherry SSE 31.70'

Nail & Tag in N side 30" Maple WSW 84.73'

L.C.R.C. Liber 6, Page 135

March 1991 (R. Milliron)

L-1 Set Cast Monument

East 46.48 to Robinson corner

S 65 E 88.81 to nail N side 6" tree

S 45 E 39.86 to nail twin 18" oak

S 65 W 84.67 to nail & tag N side 24" Maple

N 50 W 53.13 to nail SW side 14" Pine

N 15 E 29.20 to nail SW side 12" Pine

B. Description of corner evidence found and/or method applied in restoring or reestablishing corner.

L-1 Found Cast Iron Monument in Box

Scar in face twin 20" Oak S45°E 39.8'

Found Nail in N side 6" Clump S70°E 88.78'

Found Nail & Tag N side 30" Maple S75°W 84.67'

Found Nail in face 18" Pine N5°E 29.13'

Found Nail & Tag #18435 in face 14" Pine N30°W 34.05'

This corner was not monumented by the original GLO survey. This monument is accepted as the best available evidence of the position of the corner.

C. Description of monument for corner and accessories established to perpetuate locating the position of the corner.

L-1 Cast Iron Monument (0.37' South of Township line) in Mon. Box

Set Remon Tag & Nail in N side 30" Maple S75°W 84.66'

Set Remon Tag & Nail in SW side 16" Pine N35°W 52.99'

Set Remon Tag & Nail in NW side 16" Elm N65°E 87.42'


Set Remon Tag & Nail in SW side 20" twin Oak S45°E 40.34'

Robinson Corner (L-13, T7N, R15W) East 46.42'

(see sketch on back)

 Signed by Douglas J. Koning
 Surveyor's Michigan License No. 35995
Date 9-13-99

Liber 4 Page 406

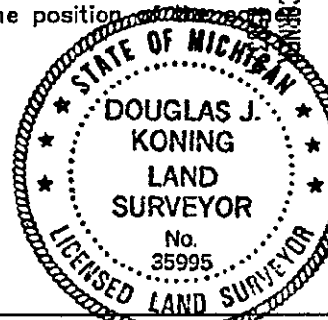

FEB 24 2000

SECTION

SECTION 36, T7N, R15W
ROBINSON TOWNSHIP

SECTION 1, T6N, R15W
OLIVE TOWNSHIP

