

SURVEY & REMONUMENTATION

DEC 01 1998

OTTAWA COUNTY REMONUMENTATION LAND CORNER RECORDATION CERTIFICATE Filing Requirement of Act 74, Mich. P.A. 1970

SECTION

For corners in

<u>Ottawa</u> (County)	Located In:	Corner Code #
1. Public Land Survey	T 7 N R 15 W	A-1
	T R	
	T R	
	T R	
2. Property Controlling	S T R	NW corner
in Section	S T R	Section 6
3. Miscellaneous	S T R	Robinson Twp
Property in Sec.	S T R	Common corner

RECORDED
98 JUL 24 PM 1:46

Sam L. Lampen
REGISTER OF DEEDS
OTTAWA COUNTY, MI

Register of Deeds Stamp & File Number

4. Lot No. _____, Recorded Plat _____
5. Private Claims _____

I, Steve Lampen, in a field survey on June 4 19 98, do hereby certify that under requirements of P.A. 74, Michigan P.A. of 1970, the corner points mentioned in lines 1 and 2 above were in conformance with regulations and rules therefore as required in the current manual of survey instructions of the United States Department of the Interior, Bureau of Land Management or by a decree of a Court of Law and/or that the corner points mentioned in lines 3, 4 and 5 above were in conformance with the rules of the Michigan Board of Land Surveyors or by a Decree of a Court of Law; established, re-established, monumented, re-monumented, recovered, found as expressed below:

NOTE: Not more than 4 corners, all in the same town and range, may be recorded on this certificate.

A. Description of original monument and accessories and/or subsequent restoration:

M-13
GLO - Britain - 1832
West on South side Sec. 31
67.70 to Grand River where raised mound.

Emmet Peck - found stone - 1907
M-13 to M-12 = 2620
M-12 to M-11 = 2620

GLO - Mullett - 1837
78.20 over Grand River 79.30
intersect range line 20 lks. N. of
temporary 5 hile post and set corner
to T7 & 8N. R15 & 16W. Raised a mound.

Carl T. Bowen - stone - 1954
Survey shows iron on Section
line 869 ft South of M-12

Emmet Peck - Survey
in Section 6, T7N, R15W
A-1 to A-2 = 40.78 ch.
A-1 to C-1 = 80.23 ch.

B. Description of corner evidence found and/or method applied in restoring or reestablishing corner:

M-13 Did not find stone.

Re-established North and South position by measuring M-12 - M-13 equal to M-12 - M-11 as measured by Peck.
measure = 2617.95, Peck = 2620

Re-established East and West position by extending M-12 and a found pipe stake 869.5' South of M-12 set by Bowen in 1954. This position measures reasonable with the Peck survey of Section 6, T7N, R15W. See sketch on back.

Set an Ottawa County Remonumentation iron and cap and is accepted as a careful and faithful re-establishment of the position of the original corner.

See sketch on back.

C. Description of monument for corner and accessories established to perpetuate locating the position of the corner:

M-13 Ottawa County Remonumentation iron and cap

Remonumentation tag in	West side	Twin 10"-16" Maple	198°	23.85
Remonumentation tag in	West	Twin 16" Ash	343°	68.10
Remonumentation tag in	South	Triple 10" Maple	238°	18.27
Remonumentation tag in	South	8" Poplar	124°	37.38

PA. 343 OTTAWA CO. CORNER
PEER APPROVED
6-15-98
PDN

Signed by Steven Lampen Date JULY 20, 1998

Surveyor's Michigan License No. 37279


FORM APPROVED BY MICHIGAN STATE BOARD OF LAND SURVEYORS, JAN. 2, 1971

REVISOR MAY 14, 1976
REVISED JAN., 1983
ADAPTED FOR WORD PROCESSING MARCH, 1993

SURVEY & REMONUMENTATION

DEC 01 1998

SECTION

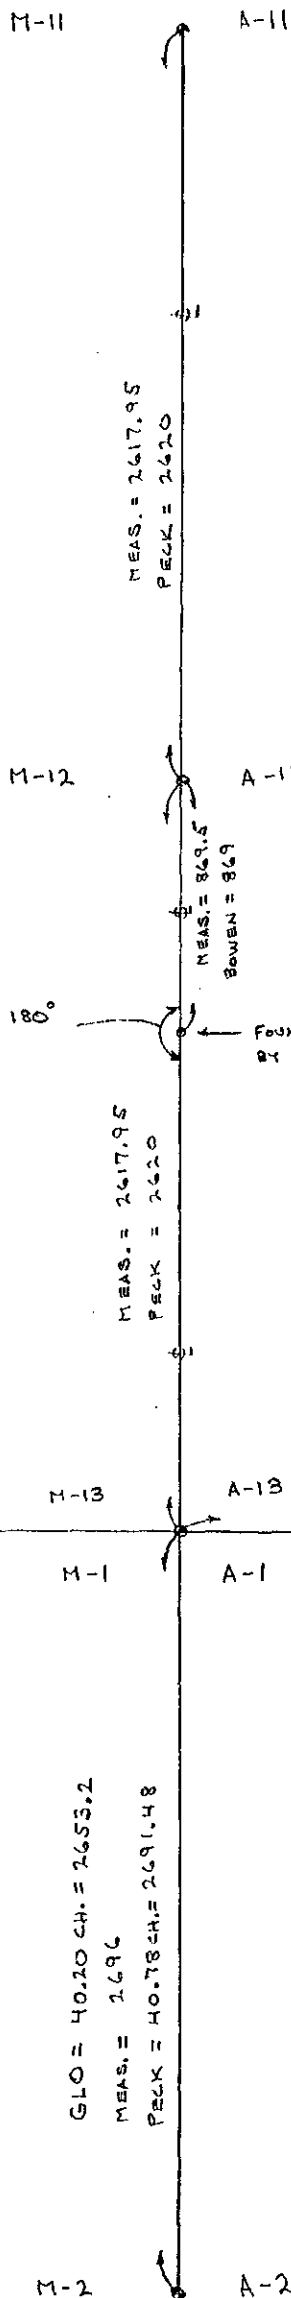

SECTION 36
T8N R16W

SECTION 31
T8N R15W

GLO = 79.30 CH. = 5233.8
MEAS. = 5277.24
PECK = 80.23 CH. = 5295.18

C-13

C-1

SECTION 1
T7N R16W

SECTION 6
T7N R15W

GLO = 40.20 CH. = 2653.2
MEAS. = 2696
PECK = 40.78 CH. = 2691.48