

SURVEY &  
REMONUMENTATION

APR 24 1995

OTTAWA COUNTY REMONUMENTATION  
LAND CORNER RECORDATION CERTIFICATE  
Filing Requirement of Act 74, Mich. P.A. 1970

RECORDED  
94 DEC 15 AM 11:51

For corner COMMISSION

Ottawa (County) Located In: Robinson Twp. Corner Code # A-8  
1. Public Land Survey T 7N R 15W W 1/4 Corner Section 19  
2. Property Controlling in Section S T R  
3. Miscellaneous Property in Sec. S T R  
4. Lot No. , Recorded Plat  
5. Private Claims

REGISTER OF DEEDS  
OTTAWA COUNTY, MI

Register of Deeds Stamp & File Number

I, Carl P. Englert, in a field survey on October 19, 1994, do hereby certify that under requirements of P.A. 74, Michigan P.A. of 1970, the corner points mentioned in lines 1 and 2 above were in conformance with regulations and rules therefore as required in the current manual of survey instructions of the United States Department of the Interior, Bureau of Land Management or by a decree of a Court of Law and/or that the corner points mentioned in lines 3, 4 and 5 above were in conformance with the rules of the Michigan Board of Land Surveyors or by a Decree of a Court of Law; established, re-established, monumented, re-monumented, recovered, found as expressed below:

NOTE: Not more than 4 corners, all in the same town and range, may be recorded on this certificate.

A. Description of original monument and accessories and/or subsequent restoration:  
A-8 W. 1/4 corner Section 19

LCRC Liber 2, Page 411 (11/29/73)  
A-8 Fd. 2" Iron Pipe  
N.W. 14.05' St. Sign  
S.W. 24.22' P.P.  
N.E. 57.76' 16" Oak  
S. 36.50' to Grand Haven Corner

LCRC Liber 5, Page 166 (12/14/84)  
A-8 Set C.I.M.  
12" Oak W 35.40  
15" Oak NW 24.23  
Power P. SW 24.22  
14" Oak NE 57.79  
G.H. Corner S 36.50

(See Back of Page)

B. Description of corner evidence found and/or method applied in restoring or reestablishing corner:  
A-8 W. 1/4 corner Section 19

Found 4" Harrison CIM  
Found G.H. Corner South 36.58'

P.A. 345 OTTAWA COUNTY

PEER APPROVED 12/12/94

Accepted as a careful and faithful perpetuation of the accepted position of the West 1/4 corner.

C. Description of monument for corner and accessories established to perpetuate locating the position of the corner:  
A-8 W. 1/4 corner Section 19


Set 3/4" x 3' long Iron bar with O.C. Remon. Cap in Mon. Box at W. edge of Pavement.  
O.C. Remon. Tag & Nail in N.W. side 24" Oak N39°E 98.96'  
O.C. Remon. Tag & Nail in W. side P.P. S19°E 184.09'  
O.C. Remon. Tag & Nail in N.W. side 30" Oak S31°W 42.72'  
O.C. Remon. Tag & Nail in S. side 15" Oak N46°W 49.18'  
O.C. Remon. Tag & Nail in S.E. side 18" Oak N16°E 173.06'  
T7N, R16W corner South 36.58'  
Corner 0.11' W. of a line between E1/4 Cor. 24-7-16 & NE Cor.

Signed by Carl P. Englert

Date 12/11/94

Surveyor's Michigan License No. 18987

FORM APPROVED BY MICHIGAN STATE BOARD OF LAND SURVEYORS, MAY 1, 1975

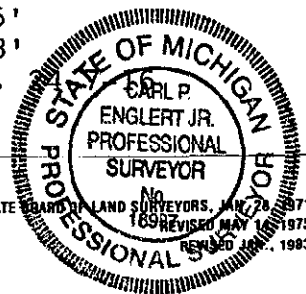

LCRC Liber 3, Page 390 (10/22/79)

A-8 found 2" Pipe

SW P. Pole 24.2'

NW TW 8" Oak 60.46'

NW ST. Sign 13.94'

NE 15" Oak 74.52'

G. Haven Corner South 36.58'

10/22/79  
# 200  
# 200  
# 200  
# 200