

# SURVEY & REMONUMENTATION

APR 24 1995

## OTTAWA COUNTY REMONUMENTATION LAND CORNER RECORDATION CERTIFICATE Filing Requirement of Act 74, Mich. P.A. 1970

RECORDED

94 DEC 15 AM 11:52

For corner **COMMISSION**

Ottawa  
(County)

Located in:  
Robinson Twp.

Corner Code ##

- |                                    |   |                   |
|------------------------------------|---|-------------------|
| 1. Public Land Survey              | T <u>7N</u> R <u>15W</u>                  | <u>C-5</u>        |
|                                    | T <u>    </u> R <u>    </u>               | <u>NW Corner</u>  |
|                                    | T <u>    </u> R <u>    </u>               | <u>Section 17</u> |
|                                    | T <u>    </u> R <u>    </u>               | <u>    </u>       |
| 2. Property Controlling in Section | S <u>    </u> T <u>    </u> R <u>    </u> | <u>    </u>       |
|                                    | S <u>    </u> T <u>    </u> R <u>    </u> | <u>    </u>       |
| 3. Miscellaneous                   | S <u>    </u> T <u>    </u> R <u>    </u> | <u>    </u>       |
| Property in Sec.                   | S <u>    </u> T <u>    </u> R <u>    </u> | <u>    </u>       |

Register of Deeds Stamp & File Number

4. Lot No.     , Recorded Plat
5. Private Claims

I, Carl P. Englert in a field survey on December 01, 19 94, do hereby certify that under requirements of P.A. 74, Michigan P.A. of 1970, the corner points mentioned in lines 1 and 2 above were in conformance with regulations and rules therefore as required in the current manual of survey instructions of the United States Department of the Interior, Bureau of Land Management or by a decree of a Court of Law and/or that the corner points mentioned in lines 3, 4 and 5 above were in conformance with the rules of the Michigan Board of Land Surveyors or by a Decree of a Court of Law; established, re-established, monumented, re-monumented, recovered, found as expressed below:

**NOTE:** Not more than 4 corners, all in the same town and range, may be recorded on this certificate.

A. Description of original monument and accessories and/or subsequent restoration:

C-5 corner common to Sections 7, 8, 17 & 18  
Original Gov't corner set May 1832  
by Calvin Britain D.S.

LCRC Liber 5, Page 275 (6/21/89)

C-5  
Set CIM in Mon. Box  
Nail in NW face 16" Oak  
Nail in SW face 12" Pine  
Nail in SE face 30" Oak  
Nail in SW face 24" Oak

Set Corner  
W. Oak 14" S30°E 5 Links  
Beech 14" N50°W 36 Links

(See Back of Sheet)

B. Description of corner evidence found and/or method applied in restoring or reestablishing corner:

C-5 corner common to Sections 7, 8, 17 & 18

Found 3" Harrison CIM in Mon. Box in E Intersection 3" deep  
Found Nail in NW Face 16" Oak N.E. 49.62'  
Found Nail in SW Face 12" Pine S.E. 67.35'  
Found Nail in SE face 30" Oak S.W. 57.36'  
Found Nail in SW face 24" Cherry N.W. 63.85'

PA. 345 OTTAWA COUNTY

PEER APPROVED

Accepted as a careful and faithful perpetuation of the original position of the corner.

C. Description of monument for corner and accessories established to perpetuate locating the position of the corner:


C-5 corner common to Sections 7, 8, 17 & 18

3" Harrison Cast Iron Monument in Mon. Box	
O.C. Remon. Tag & Nail in NW side 13" Pine	S35°E 67.30'
O.C. Remon. Tag & Nail in SE side 30" Oak	S50°W 57.34'
O.C. Remon. Tag & Nail in SW side 24" Cherry	N33°W 63.76'
O.C. Remon. Tag & Nail in NW side 18" Oak	N36°E 49.59'

Signed by Carl P. Englert Jr

Date 12/05/94

Surveyor's Michigan License No. 18987

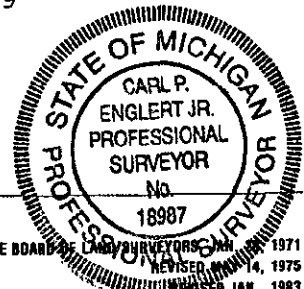

FORM APPROVED BY MICHIGAN STATE BOARD OF LAND SURVEYORS JAN. 14, 1975  
REVISED JAN., 1983

LCRC Liber 1, Page 297 (2/11/72)

C-5 Found "T" Iron in Mon. Box

Nail in Face of 20" Maple	SE	46.02'
Nail in Face of Tel. Pole	NW	57.00'
Nail in Face of 12" Oak	NE	49.18'
Nail in Face of 30" Oak	SW	55.86'

LCRC Liber 5, Page 270

C-5

"T" iron in MB

Nail and Tag in NW side 18" Oak	NE	49.62'
Nail and Tag in SW side 24" W. Cherry	NW	63.80'
Nail and Tag in SE side 30" Oak	SW	57.39'
Nail and Tag in SW side 12" Pine	SE	67.06'