

1893

Ottawa County Remonumentation

RECORDED

1893

LAND CORNER RECORDATION CERTIFICATE
Filing Requirement of Act 74, Mich. P.A. 1970

93 DEC 15 AM 9:29

COMMISSION

For corners in

Ottawa
(County)

Located In: Corner Code ##
Robinson Township

1. Public Land Survey T 7N R 15W H-13, S 1/2 corner, Section 34
T R
T R
T R
T R
2. Property Controlling S T R
in Section S T R
3. Miscellaneous S T R
Property in Sec. S T R

Register of Deeds Stamp & File Number

4. Lot No. , Recorded Plat
5. Private Claims

Carl P. Englert Jr.

I, in a field survey on July 8, 1993, do hereby certify that under requirements of P.A. 74, Michigan P.A. of 1970, the corner points mentioned in lines 1 and 2 above were in conformance with regulations and rules therefore as required in the current manual of survey instructions of the United States Department of the Interior, Bureau of Land Management or by a decree of a Court of Law and/or that the corner points mentioned in lines 3, 4 and 5 above were in conformance with the rules of the Michigan Board of Land Surveyors or by a Decree of a Court of Law; established, re-established, monumented, re-monumented, recovered, found as expressed below:

NOTE: Not more than 4 corners, all in the same town and range, may be recorded on this certificate.

- A. Description of original monument and accessories and/or subsequent restoration:
H-13

L.C.R.C., Liber 6, Page 134, May 1993

Fd. 1/2" iron bar

W. 57.48' to Olive Corner

N. 5 degrees E., 37.70' to nail S. side 24" Oak

S. 35 degrees E., 43.53' to nail N.E. side 8" Maple

S. 45 degrees W., 60.92' to nail N.W. side 12" Oak

S. 70 degrees W., 102.39' to nail N.W. side 8" Cherry

N. 55 degrees W., 86.16' to nail E. side 6" Cherry

- B. Description of corner evidence found and/or method applied in restoring or reestablishing corner:

H-13

Fd. 1/2" capped iron bar

Fd. all witnesses listed in "A" and accepted as a careful and faithful perpetuation of the position of the original corner.


- C. Description of monument for corner and accessories established to perpetuate locating the position of the corner:

H-13 Set 2' long 3/4" iron bar with O.C. Remon. Cap,
O.C. Remon. Tag & Nail in E. side 24" Oak N. 5 degrees E. 39.75'
O.C. Remon. Tag & Nail in S. side 24" Oak N. 70 degrees W. 70.75'
O.C. Remon. Tag & Nail in N.W. side 14" Oak S. 50 degrees W. 60.91'
O.C. Remon. Tag & Nail in N. side 10" Oak S. 70 degrees E. 71.14'
Olive corner W. 57.48'

	A	B	C	D	E	F	G	H	I	J	K	L	M
2	6		5		4		3		2		1		
3													
4	7		8		9		10		11		12		
5													
6	18		17		16		15		14		13		
7													
8	19		20		21		22		23		24		
9													
10	30		29		28		27		26		25		
11													
12	31		32		33		34		35		36		
13													

Signed by Carl P. Englert Jr.
Surveyor's Michigan License No. 18987

Date Oct. 6, 1993

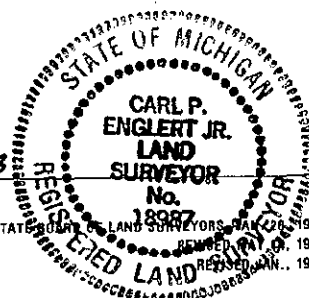

FORM APPROVED BY MICHIGAN STATE BOARD OF LAND SURVEYORS, MAY 20, 1971
REVISED JAN. 1975
REVISED JAN., 1983