

OTTAWA COUNTY REMONUMENTATION  
LAND CORNER RECORDATION CERTIFICATE  
Filing Requirement of Act 74, Mich. P.A. 1970

RECORDED

97 JUL 24 PM 2: 23

*John H. Robinson*  
REGISTER OF DEEDS  
OTTAWA COUNTY, MI

For corners in

Ottawa  
(County)

Located In:

Corner Code #

- |                                    |                         |                             |
|------------------------------------|-------------------------|-----------------------------|
| 1. Public Land Survey              | T <u>7</u> R <u>16</u>  | E-2, E $\frac{1}{2}$ corner |
|                                    | T _____ R _____         | Section 5                   |
|                                    | T _____ R _____         | Grand Haven Twp             |
|                                    | T _____ R _____         |                             |
| 2. Property Controlling in Section | S _____ T _____ R _____ |                             |
|                                    | S _____ T _____ R _____ |                             |
| 3. Miscellaneous                   | S _____ T _____ R _____ |                             |
| Property in Sec.                   | S _____ T _____ R _____ |                             |

Register of Deeds Stamp & File Number

4. Lot No. \_\_\_\_\_, Recorded Plat \_\_\_\_\_
5. Private Claims \_\_\_\_\_


I, THOMAS E. JOINER in a field survey on December 4, 19 96, do hereby certify that under requirements of P.A. 74, Michigan P.A. of 1970, the corner points mentioned in lines 1 and 2 above were in conformance with regulations and rules therefore as required in the current manual of survey instructions of the United States Department of the Interior, Bureau of Land Management or by a decree of a Court of Law and/or that the corner points mentioned in lines 3, 4 and 5 above were in conformance with the rules of the Michigan Board of Land Surveyors or by a Decree of a Court of Law; established, re-established, monumented, re-monumented, recovered, found as expressed below:

**NOTE: Not more than 4 corners, all in the same town and range, may be recorded on this certificate.**

A. Description of original monument and accessories and/or subsequent restoration:

E-2  
Calvin Britian D.S.  
May 24th 1832  
North between Sections 4 and 5  
40.00' Set  $\frac{1}{2}$  mile post  
9" Pine S 64° E 2 links  
No other near.

E-2 was set by Carl P. Englert as part of a survey done for Construction Aggregets Co. Job #1503.  
E-2 was also established by Carl P. Englert as part of a survey done for Ottawa County Parks Job #1666.  
E-2 has also been established by numerous surveys performed in the immediate area.

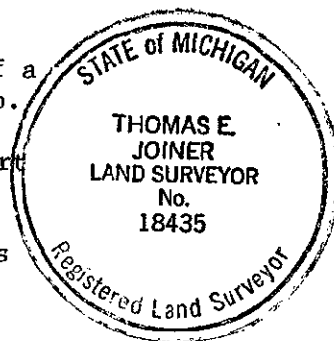

B. Description of corner evidence found and/or method applied in restoring or reestablishing corner:

E-2  
Found Ottawa County Remon Cap and Bar and accepted as a careful and faithful perpetuation of the original corner.

P.A. 345 OTTAWA COUNTY  
PEER APPROVED 12-9-96

*G.D.N.*

C. Description of monument for corner and accessories established to perpetuate locating the position of the corner:

E-2	Found Ottawa County Remon. Cap & Bar	
Ottawa County Remon tag and nail in NE side	6" Maple	AZ 119° Dist 100.09
Ottawa County Remon tag and nail in E side	10" White Pine	AZ 187° Dist 182.81
Ottawa County Remon tag and nail in N side	3" Maple	AZ 259° Dist 61.95
Ottawa County Remon tag and nail in SE side	Triple 3" Maple	AZ 27° Dist 69.54

Signed by Thomas E. Joiner  
Surveyor's Michigan License No. 18435

Date 12-6-96