

SURVEY &
REMONUMENTATION

APR 24 1995

COMMISSION

OTTAWA COUNTY REMONUMENTATION
LAND CORNER RECORDATION CERTIFICATE
Filing Requirement of Act 74, Mich. P.A. 1970

RECORDED

94 DEC 14 AM 9:40

For corners in

OTTAWA
(County)

Located In:

Corner Code ##

1. Public Land Survey T 7N R 16W E-7, SW Corner
T R Section 16
T R Grand Haven Twp.
T R
2. Property Controlling S T R
in Section S T R
3. Miscellaneous S T R
Property in Sec. S T R

Register of Deeds Stamp & File Number

4. Lot No. , Recorded Plat
5. Private Claims

I, THOMAS E. JOINER in a field survey on 10-26-, 19 94,
do hereby certify that under requirements of P.A. 74, Michigan P.A. of 1970, the corner points mentioned
in lines 1 and 2 above were in conformance with regulations and rules therefore as required in the
current manual of survey instructions of the United States Department of the Interior, Bureau of Land
Management or by a decree of a Court of Law and/or that the corner points mentioned in lines 3, 4 and 5
above were in conformance with the rules of the Michigan Board of Land Surveyors or by a Decree of a
Court of Law; established, re-established, monumented, re-monumented, recovered, found as
expressed below:

NOTE: Not more than 4 corners, all in the same town and range, may be recorded
on this certificate.


- A. Description of original monument and accessories and/or subsequent restoration:
05-24-1832 Liber 1, Pg. 669, 10-13-72
Post set by Calvin Britain, D.S. Found iron pipe
18" Aspen is post SSE 31.75 Telephone Pole
NE 40.35 Power Pole
NW 33.40 Power Pole
NW 39.50 Street Sign

3. Description of corner evidence found and/or method applied in restoring or reestablishing corner:

Found Cast Iron Monument in Monument Box and accepted as a careful and faithful perpetuation
of the position of the original corner.

Liber 1, Pg. 669, 10-13-72
SSE 31.75 Telephone Pole
NW 39.50 Street Sign

P.A. 345 OTTAWA COUNTY
DEED APPROVED 12/12/94
Madison D. Nedewell

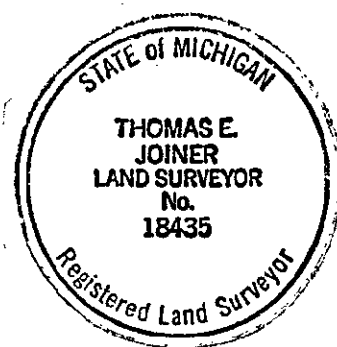

- C. Description of monument for corner and accessories established to perpetuate locating the position of the corner:

Cast Iron Monument in Monument Box

| | | |
|--|----------|-------|
| CL Top operating nut on hydrant | Az. 62° | 59.98 |
| O.C. Remon Tag & Nail in W side 12" Scotch Pine | Az. 148° | 54.77 |
| O.C. Remon Tag & Nail in W side 10" Scotch Pine | Az. 215° | 77.66 |
| O.C. Remon Tag & Nail in E side 17" Black Locust | Az. 336° | 53.66 |

Signed by Thomas E. Joiner Date 11-28-94
Surveyor's Michigan License No. 18435

FORM APPROVED BY MICHIGAN STATE BOARD OF LAND SURVEYORS, JAN. 28, 1971
REVISED MAY 14, 1975
REVISED JAN., 1983