

OTTAWA COUNTY REMONUMENTATION  
LAND CORNER RECORDATION CERTIFICATE  
Filing Requirement of Act 74, Mich. P.A. 1970

For corners in

Ottawa  
(County)

Located In:

Corner Code ##

1. Public Land Survey

T 7N R 16W

H-7, S $\frac{1}{2}$  corner

T R

Section 15

T R

Grand Haven Twp

T R

2. Property Controlling  
in Section

S T R

S T R

3. Miscellaneous

S T R

Property in Sec.

S T R

Seg. #2 pm

RECORDED

96 DEC 17 AM 10:44

REGISTER OF DEEDS  
OTTAWA COUNTY, MI

Register of Deeds Stamp & File Number

4. Lot No. , Recorded Plat

5. Private Claims

|    | A  | B  | C  | D  | E  | F  | G | H | I | J | K | L | M |
|----|----|----|----|----|----|----|---|---|---|---|---|---|---|
| 2  | 6  | 5  | 4  | 3  | 2  |    |   |   |   |   |   |   |   |
| 3  |    |    |    |    |    |    |   |   |   |   |   |   |   |
| 4  | 7  | 8  | 9  | 10 | 11 | 12 |   |   |   |   |   |   |   |
| 5  |    |    |    |    |    |    |   |   |   |   |   |   |   |
| 6  | 18 | 17 | 16 | 15 | 14 | 13 |   |   |   |   |   |   |   |
| 7  |    |    |    |    |    |    |   |   |   |   |   |   |   |
| 8  | 19 | 20 | 21 | 22 | 23 | 24 |   |   |   |   |   |   |   |
| 9  |    |    |    |    |    |    |   |   |   |   |   |   |   |
| 10 | 30 | 29 | 28 | 27 | 26 | 25 |   |   |   |   |   |   |   |
| 11 |    |    |    |    |    |    |   |   |   |   |   |   |   |
| 12 | 31 | 32 | 33 | 34 | 35 | 36 |   |   |   |   |   |   |   |
| 13 |    |    |    |    |    |    |   |   |   |   |   |   |   |

I, Thomas E. Joiner, in a field survey on October 31, 19 96

do hereby certify that under requirements of P.A. 74, Michigan P.A. of 1970, the corner points mentioned in lines 1 and 2 above were in conformance with regulations and rules therefore as required in the current manual of survey instructions of the United States Department of the Interior, Bureau of Land Management or by a decree of a Court of Law and/or that the corner points mentioned in lines 3, 4 and 5 above were in conformance with the rules of the Michigan Board of Land Surveyors or by a Decree of a Court of Law; established, re-established, monumented, re-monumented, recovered, found as expressed below:

**NOTE:** Not more than 4 corners, all in the same town and range, may be recorded on this certificate.

A. Description of original monument and accessories and/or subsequent restoration:

Set cast iron monument  
inscribed "Section Corner"  
Liber 4, Page 71 6-5-80  
15" Oak N 31.51  
12" Spruce NE 36.95  
20" Oak SE 29.93  
RxxR Sign SW 25.95

Iron Pipe  
Liber 3, Page 39 3-10-76  
16" Oak N 31.51  
12" Spruce NE 36.95  
20" Oak SE 29.93

Cast iron monument  
inscribed "Section Corner"  
Remon Liber 1, Page 279 11-19-93  
9" Oak S 03° E 62.72  
14" Cherry N 55° W 65.49  
8" Spruce S 48° E 57.39  
20" Oak N 03° W 31.00

OVER


B. Description of corner evidence found and/or method applied in restoring or reestablishing corner:

Found Cast Iron Monument and accepted as a careful and faithful perpetuation of the position of the original corner. Set Ottawa County Remon. cap over two foot long steel bar, directly over the cast iron monument. Ottawa County Road Commission will place a monument box over the cap and bar when Buchanan Street is resurfaced. This corner is part of the Road Commission improvement project.

Remon. Liber 1, Page 279  
9" Oak S 03° E 62.72  
14" Cherry N 55° W 65.49  
8" Spruce S 48° E 57.39

P.A. 345 OTTAWA COUNTY  
PEER APPROVED 11-11-96

*Handwritten signature*

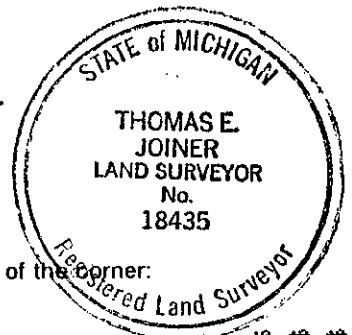

C. Description of monument for corner and accessories established to perpetuate locating the position of the corner:

Remon Cap and Bar

|                                                |               |         |             |
|------------------------------------------------|---------------|---------|-------------|
| Ottawa County Remon tag and nail in East side  | 9" Oak        | AZ 177° | Dist. 62.72 |
| Ottawa County Remon tag and nail in South side | 14" Cherry    | AZ 305° | Dist. 65.49 |
| Ottawa County Remon tag and nail in North side | 8" Spruce     | AZ 132° | Dist. 57.39 |
| Ottawa County Remon tag and nail in West side  | 12" Jack Pine | AZ 340° | Dist. 66.83 |

\$ 11.00 CORNER  
\$ 1.00 PHOTO  
\$ 1.00 PHOTO

Signed by Thomas E. Joiner

Date 11-11-96

Surveyor's Michigan License No. 18435

May 19 - 22, 1832

Set  $\frac{1}{4}$  Section Post On True Line,  
40.00 Chains From Southwest Corner

Section 15-7-16

18" Hemlock N  $62^{\circ}$  E 8 Links

3" Hemlock S  $46^{\circ}$  W 25 Links