

10-28-93

RECORDED

93 DEC 16 PM 1:01

OTTAWA COUNTY REMONUMENTATION
LAND CORNER RECORDATION CERTIFICATE
Filing Requirement of Act 74, Mich. P.A. 1970

For corners in

COMMISSION

Ottawa
(County)

Located In:

Corner Code #

- | | | | | | |
|------------------------------------|---|----|---|-----|-------------------|
| 1. Public Land Survey | T | 7N | R | 16W | J-13 S 1/4 corner |
| | T | | R | | Section 35 |
| | T | | R | | |
| | T | | R | | |
| 2. Property Controlling in Section | S | | T | R | |
| | S | | T | R | |
| 3. Miscellaneous Property in Sec. | S | | T | R | |
| | S | | T | R | |

Polychia Chellman
REGISTER OF DEEDS
OTTAWA COUNTY, MI

Register of Deeds Stamp & File Number

4. Lot No. _____, Recorded Plat _____
5. Private Claims _____

I, THOMAS E. JOINER in a field survey on 10-28- 19 93, do hereby certify that under requirements of P.A. 74, Michigan P.A. of 1970, the corner points mentioned in lines 1 and 2 above were in conformance with regulations and rules therefore as required in the current manual of survey instructions of the United States Department of the Interior, Bureau of Land Management or by a decree of a Court of Law and/or that the corner points mentioned in lines 3, 4 and 5 above were in conformance with the rules of the Michigan Board of Land Surveyors or by a Decree of a Court of Law; established, re-established, monumented, re-monumented, recovered, found as expressed below:

NOTE: Not more than 4 corners, all in the same town and range, may be recorded on this certificate.

	A	B	C	D	E	F	G	H	I	J	K	L	M
2	6	5	4	3	2	1							
3													
4	7	8	9	10	11	12							
5													
6	18	17	16	15	14	13							
7													
8	19	20	21	22	23	24							
9													
10	30	29	28	27	26	25							
11													
12	31	32	33	34	35	36							
13													

A. Description of original monument and accessories and/or subsequent restoration:

Cast Iron Monument

Cast Iron Monument Liber 1, Pg. 121
10-29-71


At record distance from S.E.
corner of Section as measured
(2645.00)

West	23.70	Conc Mon
N.E.	27.58	15" Maple
N.W.	56.82	15" Maple
South	23.36	8" Pine
N.E.	71.83	14" Black Gum

B. Description of corner evidence found and/or method applied in restoring or reestablishing corner:

Found cast iron monument and accepted as a careful and faithful perpetuation of the position of the original corner.

West 23.70 Conc Monument
N.W. 56.82 15" Maple
South 23.36 8" Pine

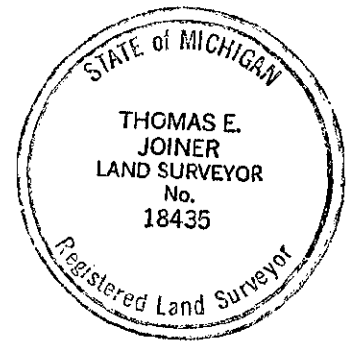

C. Description of monument for corner and accessories established to perpetuate locating the position of the corner:

Cast Iron Monument

O.C. Remon tag & nail	9"	Pepperidge	N. 20° E.	54.91
O.C. Remon tag & nail	14"	Jack Pine	N. 40° E.	59.30
O.C. Remon tag & nail	9"	Poplar	S. 45° E.	57.82
O.C. Remon tag & nail	6"	Pepperidge	S. 02° E.	29.36

Signed by Thomas E. Joiner
Surveyor's Michigan License No. 18435

Date 11-4-93