

# SURVEY & REMONUMENTATION

FEB 27 1998

## SECTION

## OTTAWA COUNTY REMONUMENTATION LAND CORNER RECORDATION CERTIFICATE Filing Requirement of Act 74, Mich. P.A. 1970

For corners in

Ottawa

(County)

Located In:

Corner Code #

1. Public Land Survey

T8N R13W

A-5 (SW, 7)

T R

Wright Twp.

T R

Common cor.

T R

to M-5,

Polkton Twp.

2. Property Controlling  
in Section

S T R

S T R

3. Miscellaneous  
Property in Sec.

S T R

S T R

4. Lot No. , Recorded Plat

5. Private Claims

I, Donald W. Schiele, in a field survey on 11-29, 1997 do hereby state that under requirements of P.A. 74, Michigan P.A. of 1970, the corner points mentioned in lines 1 and 2 above were in conformance with regulations and rules therefore as required in the current manual of survey instructions of the United States Department of the Interior, Bureau of Land Management or by a decree of a Court of Law and/or that the corner points mentioned in lines 3, 4 and 5 above were in conformance with the rules of the Michigan Board of Land Surveyors or by a Decree of a Court of Law; established, re-established, monumented, recovered, found as expressed below:

NOTE: Not more than 2 corners, all in the same town and range, may be recorded on this certificate.

### A. Description of original monument and accessories and/or subsequent restoration:

A-5 Corner common to Sections 7 & 18, Wright Twp., and Sections 12 & 13, Polkton Twp., T8N, R14W

Original Government Corner Record:

L.C.R.C. recorded in Liber 3,

Set post cor secs. 12 & 13 from which

Page 387, 9-5-79:

a Beech 13 in dia bears S40W 10 lks dist

M-5

(SEE REVERSE)

& a Do 9 " " " N22W 32 " "

3/4" iron.

Post

Nail in sde 24" Maple WSW 54.11'

John Mullett, Deputy Surveyor

Nail in sde 40" Oak SE 44.05'

April 7, 1837

C/L St. sign NW 42.7'

C/L 9' concrete road West 4.8'

### B. Description of corner evidence found and/or method applied in restoring or reestablishing corner:

A-5 Found 3/4" Steel Bar, 6" below surface of asphalt road. 60" Oak S48°30'E 43.81';

28" Maple S65°W 53.82'; Stone, 24" deep in C/L asphalt road West 5.00'.

Rejected 3/4" Steel Bar as M-5, as recorded in Liber 3, Page 387, 9-5-79. This position was originally established as a witness to the section corner.

Accepted Stone, 24" deep in centerline North & South asphalt road, as a careful and faithful perpetuation of the position of the original corner.

Found 3/4" Steel Bar N90°E 5.00'

P.A. 345 OTTAWA COUNTY

Found nail & washer in SW side of 60" Oak S52°30'E 47.49'

PEER APPROVED 12-1-97

Found nail & washer in NW side of 28" Maple S62°30'W 49.28'

### C. Description of monument for corner and accessories established to perpetuate locating the position of the corner:

A-5 Set 3/4" X 21" Steel Bar with Ottawa County Remon Cap over Stone, 2" below surface of asphalt road in Monument Box.

3/4" Steel Bar

N90°E 5.00'

Set Ottawa County Remon Tag & nail in SW side of 60" Oak

S52°30'E 47.77'

Set Ottawa County Remon Tag & nail in NW side of 28" Maple

S62°30'W 49.29'

Set Ottawa County Remon Tag & nail in SW side of 8" Ash

N71°30'W 83.98'

Set Ottawa County Remon Tag & nail in East side of Power Pole

N15°W 124.74'

On centerline asphalt road North & South

On centerline private drive to East

(SEE SKETCH ON REVERSE)

Centerline gravel road to West, 2' North

Signed by


Donald W. Schiele

Date

Dec. 1, 1997

Surveyor's Michigan License No.

23517

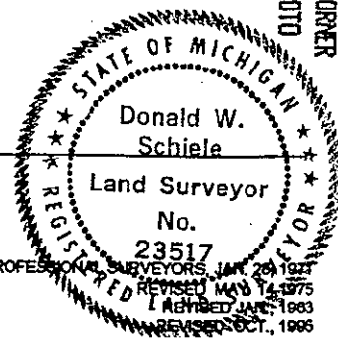

FORM APPROVED BY MICHIGAN STATE BOARD OF PROFESSIONAL SURVEYORS, JAN. 29, 1997

Part A., continued:

Ottawa County Surveyor Records (no date):

(A-5) Stake Pine Stump 36 N89½ 3.28½

Ottawa County Surveyor Records (no date):

(A-5) Stake & Stone 12" Maple S63½W 48.7  
6" Oak S50E 47.7

Ottawa County Surveyor Records (no date):

(A-5) Cement F Post N43°W 43ft.

Found stone. Planted iron bar.

Ottawa County Surveyor Records (no date):

(A-5) Set Gas Pipe 5ft E of Sec. Cor. on E. side of Concrete Road

Ottawa County Surveyor Records, 1972:

(A-5) Iron SE 44.05 to PK in 34" Oak  
SW 51.40 to PK in 18" Maple  
5' E of C/L Pavement

**SURVEY &  
REMONUMENTATION**

**FEB 27 1998**

**SECTION**

