

SURVEY & REMONUMENTATION

APR 25 1995

OTTAWA COUNTY REMONUMENTATION
LAND CORNER RECORDATION CERTIFICATE
Filing Requirement of Act 74, Mich. P.A. 1970

RECORDED

94 DEC -8 PM 12:39

COMMISSION

For corners in

Ottawa

(County)

Located In:

Corner Code ##

Public Land Survey

T 8N R 13W

E-8 (E $\frac{1}{4}$, 20)

Wright Twp.

T R

T R

T R

T R

Property Controlling in Section

S T R

S T R

Miscellaneous

S T R

Property in Sec.

S T R

Edythe Robinson
REGISTER OF DEEDS
OTTAWA COUNTY, MI

Register of Deeds Stamp & File Number

Lot No. , Recorded Plat

Private Claims

Donald W. Schiele, in a field survey on October 14, 1994

to hereby certify that under requirements of P.A. 74, Michigan P.A. of 1970, the corner points mentioned in lines 1 and 2 above were in conformance with regulations and rules therefore as required in the current manual of survey instructions of the United States Department of the Interior, Bureau of Land Management or by a decree of a Court of Law and/or that the corner points mentioned in lines 3, 4 and 5 above were in conformance with the rules of the Michigan Board of Land Surveyors or by a Decree of a Court of Law; established, re-established, monumented, re-monumented, recovered, found as expressed below:

NOTE: Not more than 4 corners, all in the same town and range, may be recorded on this certificate.

Description of original monument and accessories and/or subsequent restoration:

E-8 $\frac{1}{4}$ corner common to Sections 20 & 21, Wright Twp.

Original Government

L.C.R.C. recorded in Liber 1,

Corner Record:

Page 811, 12-8-72

Set qr sec post

Found iron from ties

between Sec. 20 & 21

T. Pole W 29.42'

Post

6" Apple NW 56.55'

Sugar 14 S31E 14

14" Pine NNE 114.40'

Do 16 S89W 24

Face of rock NE 29.37'

Enoch Hammele, Deputy Surveyor

between 9-18 and 9-26, 1838

L.C.R.C. recorded in Liber 3,
Page 15, 12-11-75

Found iron monument

Nail in P & T pole W 29.67'

Nail in 5" W. Cherry SE 36.95'

Nail in 30" Maple NNE 101.67'

(SEE REVERSE)

Description of corner evidence found and/or method applied in restoring or reestablishing corner:

E-8 Found Cast Iron Monument inscribed "Ottawa County Section Corner" $3\frac{1}{2}$ " below surface, and accepted as a careful and faithful perpetuation of the position of the original corner.

Found nail in North side of 14" Cherry S74°30'E 27.41'

Found nail in SE side of 8" Cherry S27°30'W 48.59'

Face of cut off telephone pole S87°W 29.37'

Found nail in North side of 8" Maple N89°W 23.19'

Face of 18" Apple N30°30'W 56.1'

P.A. 345 OTTAWA COUNTY

PEER APPROVED

10/17/94

Barney D. Hedewold

Description of monument for corner and accessories established to perpetuate locating the position of the corner:

E-8 Cast Iron Monument inscribed "Ottawa County Section Corner" $3\frac{1}{2}$ " below surface.

Set Ottawa County Remon Tag & nail in South side of 14" Cherry S74°30'E 27.42'

Set Ottawa County Remon Tag & nail in SE side of 8" Cherry S27°30'W 48.58'


Set Ottawa County Remon Tag & nail in North side of 8" Maple N89°W 23.23'

Set Ottawa County Remon Tag & nail in NE side of Power Pole N61°W 56.57'

Set Ottawa County Remon Tag & nail in NE side of 18" Apple N30°30'W 56.75'

Centerline gravel road North & South, 1' East

On occupation lines East & West

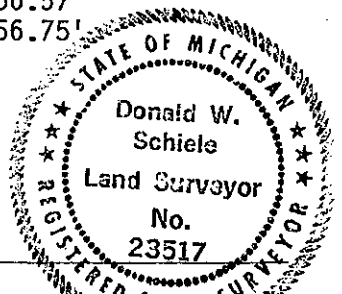

Signed by

Donald W. Schiele

Date

Oct. 17, 1994

Surveyor's Michigan License No.

23517

FORM APPROVED BY MICHIGAN STATE BOARD OF LAND SURVEYORS, JAN. 28, 1971

REVISED MAY 14, 1975

REVISED JAN., 1983

PART A. continued:

L.C.R.C. recorded in Liber 3, Page 58, 3-29-76

E-8

Set cast iron Mon.

14" Pine NNE 115.20'

24" Maple NNE 101.70'

8" Apple NW 57.13'

Tel. pole W 29.52'