

SURVEY & REMONUMENTATION

DEC 01 1998

SECTION

OTTAWA COUNTY REMONUMENTATION LAND CORNER RECORDATION CERTIFICATE Filing Requirement of Act 74, Mich. P.A. 1970

RECORDED
98 JUL 21 PM 12:14

Gary Schiele
REGISTER OF DEEDS
OTTAWA COUNTY, MI

For corners in

Ottawa

(County)

Located in:

Corner Code #

1. Public Land Survey

T 8N R 13W I-3 (NW, 11)
Wright Twp.

2. Property Controlling in Section

S T R
S T R
S T R
S T R

3. Miscellaneous Property in Sec.

4. Lot No. _____, Recorded Plat _____
5. Private Claims _____

Register of Deeds Stamp & File Number

I, Donald W. Schiele, in a field survey on June 10, 1998 do hereby state that under requirements of P.A. 74, Michigan P.A. of 1970, the corner points mentioned in lines 1 and 2 above were in conformance with regulations and rules therefore as required in the current manual of survey instructions of the United States Department of the Interior, Bureau of Land Management or by a decree of a Court of Law and/or that the corner points mentioned in lines 3, 4 and 5 above were in conformance with the rules of the Michigan Board of Land Surveyors or by a Decree of a Court of Law; established, re-established, monumented, recovered, found as expressed below:

NOTE: Not more than 2 corners, all in the same town and range, may be recorded on this certificate.

	A	B	C	D	E	F	G	H	I	J	K	L	M
1													
2	6		5		4		3		2		1		
3													
4	7		8		9		10		11		12		
5													
6	18		17		16		15		14		13		
7													
8	19		20		21		22		23		24		
9													
10	30		29		28		27		26		25		
11													
12	31		32		33		34		35		36		
13													

A. Description of original monument and accessories and/or subsequent restoration:

I-3: Corner common to Sections 2, 3, 10 & 11, Wright Twp.
Original Government Corner Record: From Consumers Power Co. records, 1968:
Set stake cor Secs 2,3,10,11 Set 3/4" Iron on SE side of fence post
Stake 30" Ash W 43.5'
Beech 24 N15E 23 30" Beech (Crooked) NNW 52.5'
do 20 S54W 14 14" Maple N 72.00'

Enoch Hammele, Deputy Surveyor, for
Rasselas Whitcomb, Deputy Surveyor
Between 9-18 & 9-26, 1838

B. Description of corner evidence found and/or method applied in restoring or reestablishing corner:

I-3 Found 3/4" Steel Bar, and accepted as a careful and faithful perpetuation of the position of the original corner.
Centerline 22" Maple N05°E 72.6'
Centerline 32" Twin Ash N86°W 44.6'

PA. 345 OTTAWA COUNTY
PEER APPROVED 6-15-98

G.D.N.


C. Description of monument for corner and accessories established to perpetuate locating the position of the corner:

I-3 Removed 3/4" X 19" Steel Bar and replaced with 3/4" X 36" Steel Bar with Ottawa County Remon Cap, at ground level.
Set Ottawa County Remon Tag & nail in East side of 22" Maple N05°E 72.58'
Set Ottawa County Remon Tag & nail in North side of 10" Cherry N87°E 19.82'
Set Ottawa County Remon Tag & nail in West side of 12" Ash S14°E 6.04'
Set Ottawa County Remon Tag & nail in North side of 32" Twin Ash N86°W 44.62'
On fence remnant lines North, South & West
On occupation line East
Found rock, 1.1' West
(SEE SKETCH ON REVERSE)

Signed by Donald W. Schiele

Date 6-15-1998

Surveyor's Michigan License No. 23517

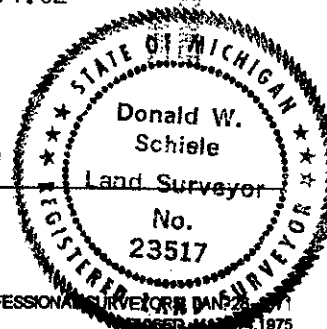

FORM APPROVED BY MICHIGAN STATE BOARD OF PROFESSIONAL SURVEYORS JAN 23, 1975

SURVEY &
REMONUMENTATION

DEC 01 1998

SECTION

