

SURVEY &
REMONUMENTATION

APR 24 1995

OTTAWA COUNTY REMONUMENTATION
LAND CORNER RECORDATION CERTIFICATE
Filing Requirement of Act 74, Mich. P.A. 1970

RECORDED

94 DEC 15 AM 11:53

For corner COMMISSION

Ottawa
(County)

Located In:

Corner Code #

1. Public Land Survey

T 8N R 13W

I-12 (W $\frac{1}{4}$, 35)

Wright Twp.

T R

T R

T R

2. Property Controlling
in Section

S T R

S T R

3. Miscellaneous

S T R

Property in Sec.

S T R

4. Lot No. , Recorded Plat

5. Private Claims

Robert A. Schiele
REGISTER OF DEEDS
OTTAWA COUNTY, MI

Register of Deeds Stamp & File Number

I, Donald W. Schiele, in a field survey on November 29, 19 94, do hereby certify that under requirements of P.A. 74, Michigan P.A. of 1970, the corner points mentioned in lines 1 and 2 above were in conformance with regulations and rules therefore as required in the current manual of survey instructions of the United States Department of the Interior, Bureau of Land Management or by a decree of a Court of Law and/or that the corner points mentioned in lines 3, 4 and 5 above were in conformance with the rules of the Michigan Board of Land Surveyors or by a Decree of a Court of Law; established, re-established, monumented, re-monumented, recovered, found as expressed below:

NOTE: Not more than 4 corners, all in the same town and range, may be recorded on this certificate.

A. Description of original monument and accessories and/or subsequent restoration:

I-12 $\frac{1}{4}$ corner common to Sections 34 & 35, Wright Twp.

Original Government Corner Record:

Set qr sec post in creek between Sec. 34 & 35

Post

Elm 10 N55W 31

Ash 6 S50E 56

Enoch Hammele, Deputy Surveyor

Between 9-18 and 9-26, 1838

L.C.R.C. recorded in Liber 2, Page 129, 5-7-73

"T" Iron

S.E. 10.25' Fence Post

W.N.W. 20" Walnut 15.48'

S. Leg of Marne Exit Sign E. 114.90'

(SEE REVERSE)

B. Description of corner evidence found and/or method applied in restoring or reestablishing corner:

I-12 Found Cast Iron Monument inscribed "Ottawa County Section Corner", 3" below surface, and accepted as a careful and faithful perpetuation of the position of the original corner.

Right-of-Way Fence S27°W 6.5'

Found nail in NW side of 10" Basswood S56°W 32.35'

Found nail in SW side of 32" Walnut N75°W 16.66'

P.A. 345 OTTAWA COUNTY

PEER APPROVED

12/12/94

Robert D. Nedwell

C. Description of monument for corner and accessories established to perpetuate locating the position of the corner:


I-12 Cast Iron Monument inscribed "Ottawa County Section Corner", 3" below surface.

Set Ottawa County Remon Tag & nail in NE side of 14" Basswood S60°E 49.08'

Set Ottawa County Remon Tag & nail in East side of 10" Maple South 45.69'

Set Ottawa County Remon Tag & nail in NW side of 10" Basswood S56°W 32.32'

Set Ottawa County Remon Tag & nail in NE side of 32" Walnut N75°W 16.25'

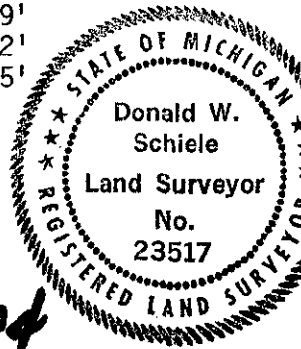

Signed by Donald W. Schiele

Date Dec. 12, 1994

Surveyor's Michigan License No. 23517

FORM APPROVED BY MICHIGAN STATE BOARD OF LAND SURVEYORS, JAN. 28, 1971
REVISED MAY 14, 1975
REVISED JAN., 1983

PART A. continued:

L.C.R.C. recorded in Liber 2, Page 824, 10-20-75

I-12

"T" Iron

Spike in top of guard rail post	NNW	56.95'
Spike in top of guard rail post	NE	48.66'
24" Butternut	W	16.67'
Iron pipe (MDSH)	W	8.70'
R/W Fence	SSW	6.5'

L.C.R.C. recorded in Liber 3, Page 17, 12-11-75

I-12 Found "T" Iron

Nail in 24" Walnut	W	16.66'
Nail in top of guard rail	NE	48.57'
Nail in top of guard rail	N	56.79'
Round iron	W	8.81'

L.C.R.C. recorded in Liber 3, Page 50, 3-29-76

I-12

Set cast iron Mon.

Spike in top of guard rail post	NE	48.66'
Spike in top of guard rail post	NNW	56.95'
Spike in S. face of 24" Walnut	W	16.77'
R/W fence	S	6.50'