

SURVEY & REMONUMENTATION

APR 24 1995

OTTAWA COUNTY REMONUMENTATION LAND CORNER RECORDATION CERTIFICATE Filing Requirement of Act 74, Mich. P.A. 1970

RECORDED

94 DEC 14 AM 9:41

For corners in COMMISSION

Register of Deeds
REGISTER OF DEEDS
OTTAWA COUNTY, MI

Ottawa (County) Located In: Corner Code ##

1. Public Land Survey	T 8N R 13W	M-4 (E $\frac{1}{4}$, 12)
	T R	Wright Twp.
	T R	
	T R	
2. Property Controlling in Section	S T R	
	S T R	
3. Miscellaneous Property in Sec.	S T R	
	S T R	

Register of Deeds Stamp & File Number

4. Lot No. _____ Recorded Plat _____
5. Private Claims _____

	A	B	C	D	E	F	G	H	I	J	K	L	M
2	6		5		4		3		2		1		
3													
4	7		8		9		10		11		12		
5													
6	18		17		16		15		14		13		
7													
8	19		20		21		22		23		24		
9													
10	30		29		28		27		26		25		
11													
12	31		32		33		34		35		36		
13													

I, Donald W. Schiele, in a field survey on December 9, 19 94, do hereby certify that under requirements of P.A. 74, Michigan P.A. of 1970, the corner points mentioned in lines 1 and 2 above were in conformance with regulations and rules therefore as required in the current manual of survey instructions of the United States Department of the Interior, Bureau of Land Management or by a decree of a Court of Law and/or that the corner points mentioned in lines 3, 4 and 5 above were in conformance with the rules of the Michigan Board of Land Surveyors or by a Decree of a Court of Law; established, re-established, monumented, re-monumented, recovered, found as expressed below:

NOTE: Not more than 4 corners, all in the same town and range, may be recorded on this certificate.

A. Description of original monument and accessories and/or subsequent restoration:

M-4 East $\frac{1}{4}$ corner, Section 12, Wright Twp.

Original Government Corner Record:

L.C.R.C. recorded in Liber 6, Page 96, 1-28-91

Set qr sec post on East side Sec. 12

Found CIM

Post

9" Twin Cherry NE 50.29'

Beech 12 N10W 25

10" Hickory ENE 27.90'

Do 18 S60W 30

16" Elm SW 46.62'

Noah Brookfield, Deputy Surveyor

12" Maple NW 27.44'

April 26, 1837

B. Description of corner evidence found and/or method applied in restoring or reestablishing corner:

M-4 Found Cast Iron Monument inscribed "Kent County Monument", 7" below surface, and accepted as a careful and faithful perpetuation of the position of the original corner.

Found nail in NW side of 8" Twin Cherry

N22°E 50.27'

Found Kent County Remon Tag & nail in North side of 14" Hickory

N75°30'E 27.86'

Found Kent County Remon Tag & nail in SE side of 18" Twin Ash

S31°W 46.51'

Found concrete nail in SE side of 18" Twin Ash

S31°W 46.59'

Found Kent County Remon Tag & nail in NW side of 12" Ash

S55°W 40.41'

Found Kent County Remon Tag & nail in North side of 18" Hickory

N78°30'W 26.20'

Centerline 15" Maple

N58°30'W 27.4'

Found Kent County Remon Tag & nail in SW side of 10" Twin Hickory

N37°W 47.24'

PA. 345 OTTAWA COUNTY

PEER APPROVED 12/12/94

C. Description of monument for corner and accessories established to perpetuate locating the position of the corner:

M-4 Cast Iron Monument inscribed "Kent County Monument", 7" below surface.

Set Ottawa County Remon Tag & nail in NW side of 8" Twin Cherry

N22°E 50.15'

Set Ottawa County Remon Tag & nail in North side of 14" Hickory

N75°30'E 27.96'

Set Ottawa County Remon Tag & nail in SE side of 18" Twin Ash

S31°W 46.49'


Set Ottawa County Remon Tag & nail in NE side of 15" Maple

N58°30'W 27.36'

On centerline gravel road North & South

Fence line to East, 1' North

On occupation line to West, ±

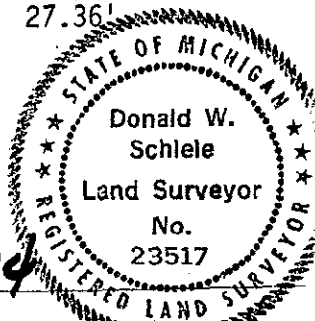

Signed by

Donald W. Schiele

Date

Dec. 12, 1994

Surveyor's Michigan License No.

23517