

SURVEY & REMONUMENTATION

APR 24 1995

OTTAWA COUNTY REMONUMENTATION
LAND CORNER RECORDATION CERTIFICATE
 Filing Requirement of Act 74, Mich. P.A. 1970

RECORDED

94 DEC 15 AM 11:53

COMMISSION

For corners in

Ottawa
(County)

Located In:


Corner Code #

- | | | |
|------------------------------------|--------------------------|--|
| 1. Public Land Survey | T <u>8N</u> R <u>16W</u> | F-3, S $\frac{1}{2}$ Cor.
Section 4
Spring Lake Twp. |
| | T _____ R _____ | _____ |
| | T _____ R _____ | _____ |
| | T _____ R _____ | _____ |
| 2. Property Controlling in Section | S _____ T _____ R _____ | _____ |
| | S _____ T _____ R _____ | _____ |
| 3. Miscellaneous Property in Sec. | S _____ T _____ R _____ | _____ |
| | S _____ T _____ R _____ | _____ |
4. Lot No. _____, Recorded Plat _____
5. Private Claims _____

Deborah A. Williams
 REGISTER OF DEEDS
 OTTAWA COUNTY, MI

Register of Deeds Stamp & File Number

I, THOMAS E. JOINER in a field survey on 11-29-, 19 94, do hereby certify that under requirements of P.A. 74, Michigan P.A. of 1970, the corner points mentioned in lines 1 and 2 above were in conformance with regulations and rules therefore as required in the current manual of survey instructions of the United States Department of the Interior, Bureau of Land Management or by a decree of a Court of Law and/or that the corner points mentioned in lines 3, 4 and 5 above were in conformance with the rules of the Michigan Board of Land Surveyors or by a Decree of a Court of Law; established, re-established, monumented, re-monumented, recovered, found as expressed below:

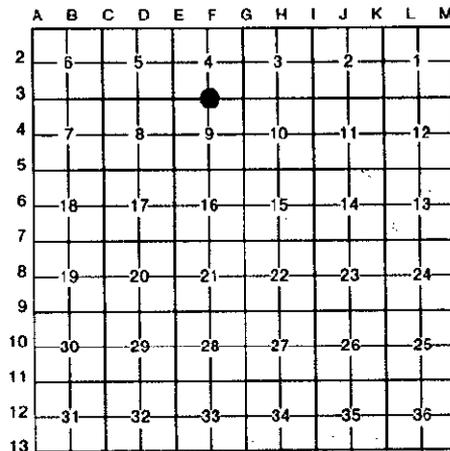

NOTE: Not more than 4 corners, all in the same town and range, may be recorded on this certificate.

A. Description of original monument and accessories and/or subsequent restoration:

04-01-1837	Liber 5, Pg. 153-A, 10-29-84	Liber 5, Pg. 29, 03-04-83
Post set by John Mullet, D.S.	Ottawa County Cast Monument	Set Cast Monument
N 87°E 13 12" Beech	East 14.92 E West Rail Tracks	East 14.92 E W. Rail
S 23°W 16 9" Beech	NW 28.20 Light Pole	NW 28.20 Light Pole
	South 31.87 E of Crossing Sign	South 31.87 E Crossing Sign
	NNW 57.88 PK in East Side T.P.	
	SW 75.84 PK in North Side P.P.	

(Continued on back)

B. Description of corner evidence found and/or method applied in restoring or reestablishing corner:

Found Cast Iron Monument in Monument Box and accepted as a careful and faithful perpetuation of the position of the original corner.

Liber 5, Pg. 153-A, 10-29-84	Liber 2, Pg. 303, 09-13-73
East 14.92 E West Rail Tracks	East 14.92 E W. Rail
South 31.87 E of Crossing Sign	South 31.87 E Crossing Sign
SW 75.84 PK in North Side P.P.	
Liber 5, Pg. 29, 03-04-83	Liber 1, Pg. 715, 10-27-72
East 14.92 E W. Rail	SE 93.74 Power Pole
South 31.87 E Crossing Sign	



C. Description of monument for corner and accessories established to perpetuate locating the position of the corner:

Cast Iron Monument in Monument Box

Cut "+" in N. End 24" Conc. Culvert	Az. 60°	38.02
O.C. Remon. Tag & Nail in W side Power Pole	Az. 140°	94.39
O.C. Remon. Tag & Nail in SE side Power Pole	Az. 238°	75.74
O.C. Remon. Tag & Nail in S side Power/Light Pole	Az. 325°	35.47
E West Rail of RR Tracks	Az. 90°	14.92

P.A. 345 OTTAWA COUNTY

PEER APPROVED *Thomas E. Joiner*

Signed by Thomas E. Joiner

Date 12-17-94

Surveyor's Michigan License No. 18435

Part A (cont.)

Liber 2, Pg. 303, 09-13-73

Found 3/4" Iron Pipe

East 14.92 @ W. Rail

NW 28.20 Light Pole

South 31.87 @ Crossing Sign

ENE 67.83 Power Pole

Liber 1, Pg. 715, 10-27-72

Found 1" Pipe

NW 28.08 Telephone Pole

NE 40.80 Cross Buck

SE 93.74 Power Pole

SSW 50.64 Telephone Guy Pole

REMON LIBER 2 PAGE 417

0013 # 3000
0014 # 3000
0015 # 3000

0013 # 3000
0014 # 3000
0015 # 3000