

OTTAWA COUNTY REMONUMENTATION  
LAND CORNER RECORDATION CERTIFICATE  
Filing Requirement of Act 74, Mich. P.A. 1970

RECORDED

94 MAY -6 AM 10:55

For corners in

OTTAWA (County) Located In: Corner Code #

1. Public Land Survey	T 8N R 16W	H-3, S1 Corner
	T R	Section 3
	T R	Spring Lake Twp.
	T R	
2. Property Controlling in Section	S T R	
	S T R	
3. Miscellaneous Property in Sec.	S T R	
	S T R	

*Edgar D. Hedewill*  
REGISTER OF DEEDS  
OTTAWA COUNTY, MI

Register of Deeds Stamp & File Number

4. Lot No. Recorded Plat  
5. Private Claims

I, THOMAS E. JOINER, in a field survey on APRIL 11, 19 94, do hereby certify that under requirements of P.A. 74, Michigan P.A. of 1970, the corner points mentioned in lines 1 and 2 above were in conformance with regulations and rules therefore as required in the current manual of survey instructions of the United States Department of the Interior, Bureau of Land Management or by a decree of a Court of Law and/or that the corner points mentioned in lines 3, 4 and 5 above were in conformance with the rules of the Michigan Board of Land Surveyors or by a Decree of a Court of Law; established, re-established, monumented, re-monumented, recovered, found as expressed below:

NOTE: Not more than 4 corners, all in the same town and range, may be recorded on this certificate.

A. Description of original monument and accessories and/or subsequent restoration:

03-30-1837	Liber 2, Pg. 159, 05-22-73
Post set by John Mullet, D.S.	Liber 4, Pg. 158, 04-01-81
N11°E 34 15" Hemlock	Set Cast Iron Monument
S39°W 37 12" Maple	SE 42.68 Power Pole
	NNW 36.49 Power Pole
	North 36.89 4" Pine
	NE 92.77 8" Juniper

B. Description of corner evidence found and/or method applied in restoring or reestablishing corner:


Found broken off Cast Iron Monument in Monument Box and accepted as a careful and faithful perpetuation of the position of the original corner.

SE 42.68 Power Pole  
NNW 36.49 Power Pole  
NE 92.77 8" Juniper

SURVEY &  
REMONUMENTATION

OCT 24 1994

COMMISSION

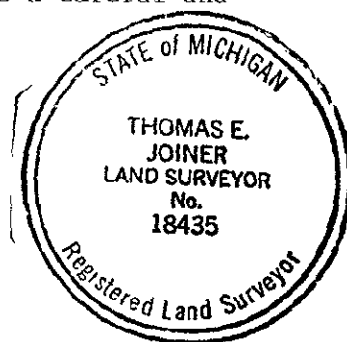

C. Description of monument for corner and accessories established to perpetuate locating the position of the corner:

Found broken off Cast Iron Monument in Monument Box and raised with O.C.R. Cap and Iron	
O.C. Remon. Tag & Nail in SE Side 8" Juniper	Az. 72°51' 93.18
O.C. Remon. Tag & Nail in NE Side Power Pole	Az. 128°14' 42.83
O.C. Remon. Corner Brick House #16390	Az. 213°17' 87.77
O.C. Remon. Tag & Nail in West Side Power Pole	Az. 345°12' 37.26

LA, 045 OTTAWA COUNTY

PEER APPROVED

*Edgar D. Hedewill*

ned by Thomas E. Joiner  
veyor's Michigan License No. 18435

Date 4-15-94