

Ottawa County Remonumentation
LAND CORNER RECORDATION CERTIFICATE
Filing Requirement of Act 74, Mich. P.A. 1970

RECORDED

94 MAY -6 AM 10:55

For corners in

Ottawa
(County)

Located In:

Corner Code #

1. Public Land Survey T 8N R 16W K-7, SW Corner
T R Section 13
T R Spring Lake Twp.
T R
2. Property Controlling S T R
in Section S T R
3. Miscellaneous S T R
Property in Sec. S T R

Register of Deeds Stamp & File Number

4. Lot No. , Recorded Plat

5. Private Claims

I, THOMAS E. JOINER in a field survey on APRIL 12, 19 94, do hereby certify that under requirements of P.A. 74, Michigan P.A. of 1970, the corner points mentioned in lines 1 and 2 above were in conformance with regulations and rules therefore as required in the current manual of survey instructions of the United States Department of the Interior, Bureau of Land Management or by a decree of a Court of Law and/or that the corner points mentioned in lines 3, 4 and 5 above were in conformance with the rules of the Michigan Board of Land Surveyors or by a Decree of a Court of Law; established, re-established, monumented, re-monumented, recovered, found as expressed below:

NOTE: Not more than 4 corners, all in the same town and range, may be recorded on this certificate.

A. Description of original monument and accessories and/or subsequent restoration:

03-27-1837 Liber 1, Pg. 91, 10-04-71 SW 47.40 Nail & Tag in
Post set by John Mullet, D.S. Liber 4, Pg. 296, 01-29-82 NE Side 36" Oak
S30°W 32 14" Pine Liber 5, Pg. 36, 03-04-83
N51°E 34 18" Oak Liber 5, Pg. 218, 05-31-85
Found Ottawa County Cast Iron Monument
NW 88.02 SE Corner House #15205
NW 45.27 Nail & Tag in South Side 22" Maple
NE 42.02 Nail & Tag in SW Side 20" Maple
SE 101.50 NW Corner House Foundation
SE 35.38 Nail & Tag in NW Side Power Pole

B. Description of corner evidence found and/or method applied in restoring or reestablishing corner:


Found Ottawa County cast iron monument in monument box and accepted as a careful and and faithful perpetuation of the position of the original corner.

NW 45.27 Nail & Tag in South Side 22" Maple

SURVEY &
REMONUMENTATION

OCT 24 1994

COMMISSION

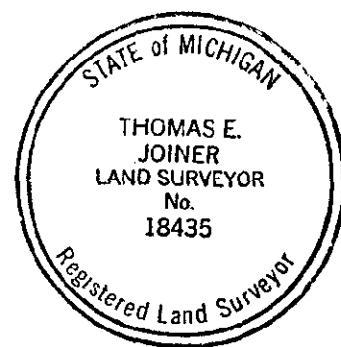

C. Description of monument for corner and accessories established to perpetuate locating the position of the corner:

Ottawa County Cast Iron Monument in Box.

O.C. Remon. Tag & Nail in South Side Power Pole	Az. 0°00'	24.75
O.C. Remon. Tag & Nail in West Side Power Pole	Az. 163°00'	65.57
O.C. Remon. Tag & Nail in NE Side 30" Oak	Az. 120°00'	66.35
House #15205 SE Corner Conc. Foundation	Az. 345°00'	86.34
O.C. Remon. Tag & Nail in SW Side 30" Maple	Az. 305°00'	45.76

RA 346 OTTAWA COUNTY

PEER APPROVED

Gordon D. Hedervell
4-15-94

Signed by

Thomas E. Joiner
18435

Date

Surveyor's Michigan License No.

FORM APPROVED BY MICHIGAN STATE BOARD OF LAND SURVEYORS, JAN. 28, 1971
REVISED MAY 14, 1975
REVISED JAN., 1983