

APR 05 1996

COMMISSION

OTTAWA COUNTY REMONUMENTATION
LAND CORNER RECORDATION CERTIFICATE
Filing Requirement of Act 74, Mich. P.A. 1970

For corners in

Ottawa (County)	Located In:	Corner Code #
1. Public Land Survey	T 8N R 16W	L-11, S $\frac{1}{2}$ corner
	T R	Section 25
	T R	Spring Lake Twp
	T R	
2. Property Controlling in Section	S T R	
	S T R	
3. Miscellaneous Property in Sec.	S T R	
	S T R	

RECORDED

95 NOV 29 PM 1:34

Elizabeth Hallman
REGISTER OF DEEDS
OTTAWA COUNTY, MI

Register of Deeds Stamp & File Number

4. Lot No. _____, Recorded Plat _____
5. Private Claims _____

I, Thomas E. Joiner, in a field survey on 11/7, 1995, do hereby certify that under requirements of P.A. 74, Michigan P.A. of 1970, the corner points mentioned in lines 1 and 2 above were in conformance with regulations and rules therefore as required in the current manual of survey instructions of the United States Department of the Interior, Bureau of Land Management or by a decree of a Court of Law and/or that the corner points mentioned in lines 3, 4 and 5 above were in conformance with the rules of the Michigan Board of Land Surveyors or by a Decree of a Court of Law; established, re-established, monumented, re-monumented, recovered, found as expressed below:

NOTE: Not more than 4 corners, all in the same town and range, may be recorded on this certificate.

A. Description of original monument and accessories and/or subsequent restoration:

03-27-1837	Liber 3, Page 391	10-24-79	Liber 4, Page 158	04-01-81
Post Set By Calvin Britain, D.S.	Found Iron		Found Iron Pipe	
S 88°E 51 12" White Oak	14" Ash NE 21.07		Set Cast Iron Monument	
	12" Oak NE 11.50		18" Ash ENE 21.83	
	8" Oak NW 14.78		15" Oak NE 11.97	
			8" Oak NW 11.07	


B. Description of corner evidence found and/or method applied in restoring or reestablishing corner:

Found Cast Iron Monument in Monument Box and accepted as a careful and faithful perpetuation of the position of the original corner.

Liber 4, Page 158
18" Ash ENE 21.83
15" Oak NE 11.97

RA. 345 OTTAWA COUNTY
PEER APPROVED 11/20/95

Victory D. Nedewell
LDN

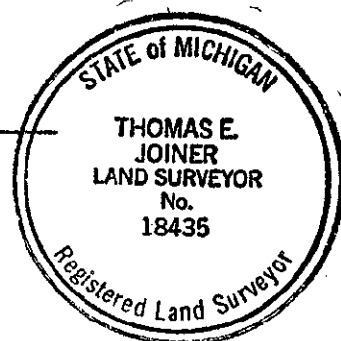

C. Description of monument for corner and accessories established to perpetuate locating the position of the corner:

Cast Iron Monument

O.C. Remon Tag & Nail in SE side 19" Oak	AZ 71°	11.99
O.C. Remon Tag & Nail in SW side 15" Oak	AZ 336°	13.89
O.C. Remon Tag & Nail in E side 14" Ash	AZ 215°	41.20
SW Corner Poured Concrete Wall Foundation	AZ 122°	122.68
House #14676 Boom Road		

Signed by Thomas E. Joiner

Date 11-16-95

Surveyor's Michigan License No. 18435