

SURVEY &
REMONUMENTATION

APR 24 1995

COMMISSION

OTTAWA COUNTY REMONUMENTATION
LAND CORNER RECORDATION CERTIFICATE
Filing Requirement of Act 74, Mich. P.A. 1970

RECORDED

94 DEC 15 AM 11:46

Phyllis Robinson
REGISTER OF DEEDS
OTTAWA COUNTY, MI

For corners in

Ottawa (County)	Located In:	Corner Code #
1. Public Land Survey	T 8N R 16W	M-4, E $\frac{1}{2}$ Cor. Section 12 Spring Lake Twp.
	T R	
	T R	
	T R	
2. Property Controlling in Section	S T R	
	S T R	
3. Miscellaneous Property in Sec.	S T R	
	S T R	
4. Lot No. _____, Recorded Plat _____		
5. Private Claims _____		

Register of Deeds Stamp & File Number

I, THOMAS E. JOINER in a field survey on 11-29- 19 94,
do hereby certify that under requirements of P.A. 74, Michigan P.A. of 1970, the corner points mentioned
in lines 1 and 2 above were in conformance with regulations and rules therefore as required in the
current manual of survey instructions of the United States Department of the Interior, Bureau of Land
Management or by a decree of a Court of Law and/or that the corner points mentioned in lines 3, 4 and 5
above were in conformance with the rules of the Michigan Board of Land Surveyors or by a Decree of a
Court of Law; established, re-established, monumented, re-monumented, recovered, found as
expressed below:

**NOTE: Not more than 4 corners, all in the same town and range, may be recorded
on this certificate.**


A. Description of original monument and accessories and/or subsequent restoration:
1837 Liber 1, Pg. 83, 09-24-71
Post set by John Mullet, D.S. Found 2" Iron Pipe
N 07°W 11 10" Maple NE 66.05 SW Hse. Cor.
S 43°W 50 10" Maple NW 88.70 SE Hse. Cor.
East 23.64 28" Oak
NE 35.10 28" Maple
NW 82.43 Telephone Pole
SW 79.53 10" Pine

B. Description of corner evidence found and/or method applied in restoring or reestablishing corner:
Found Cast Iron Monument in Monument Box and accepted as a careful and faithful
perpetuation of the position of the original corner.

Liber 1, Pg. 83, 09-24-71
NW 88.70 SE Hse. Cor.
SW 79.53 10" Pine

P.A. 345 OTTAWA COUNTY
PEER APPROVED 12/12/94

Morday D. Neders

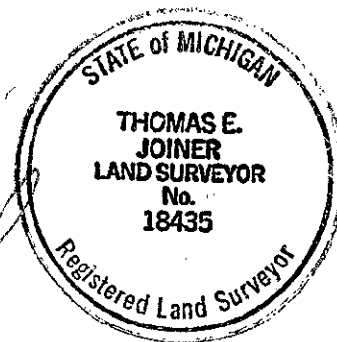

C. Description of monument for corner and accessories established to perpetuate locating the position of the corner:
Cast Iron Monument in Monument Box

O.C. Remon. Tag & Nail in W side 42" Ash	Az. 26°	91.92
E Top Operating Nut on Hydrant	Az. 92°	29.33
O.C. Remon. Tag & Nail in SE Side 27" White Pine	Az. 250°	55.01
SE Cor. House #18007	Az. 281°	88.57

Signed by Thomas E. Joiner Date 12-12-94
Surveyor's Michigan License No. 18435

FORM APPROVED BY MICHIGAN STATE BOARD OF LAND SURVEYORS, JAN. 28, 1971
REVISED MAY 14, 1975
REVISED JAN., 1983