

SURVEY & REMONUMENTATION

FEB 27 1998

OTTAWA COUNTY REMONUMENTATION LAND CORNER RECORDATION CERTIFICATE Filing Requirement of Act 74, Mich. P.A. 1970

For corners in
Ottawa

(County)

Located In:

Corner Code #

1. Public Land Survey

T8N R16W

E-7, 8

T R

G.L.O. meander post
between Sections 20
and 21

T R

T R

2. Property Controlling
in Section

S20 T8N R16W

SEQUENTIAL

S21 T8N R16W

CORNER #11

3. Miscellaneous
Property in Sec.

S T R

S T R

4. Lot No. , Recorded Plat

5. Private Claims

I, Steve Lampen, in a field survey on November 29, 1997, do hereby certify that under requirements of P.A. 74, Michigan P.A. of 1970, the corner points mentioned in lines 1 and 2 above were in conformance with regulations and rules therefore as required in the current manual of survey instructions of the United States Department of the Interior, Bureau of Land Management or by a decree of a Court of Law and/or that the corner points mentioned in lines 3, 4 and 5 above were in conformance with the rules of the Michigan Board of Land Surveyors or by a Decree of a Court of Law; established, re-established, monumented, re-monumented, recovered, found as expressed below:

NOTE: Not more than 4 corners, all in the same town and range, may be recorded on this certificate.

A. Description of original monument and accessories and/or subsequent restoration:

G.L.O. - M. P. between Section 20 and 21

G.L.O. - Britain - 1832 - North between Section 20 and 21

55.00 Grand River and set meander post

Black Ash 15 S 9 1/2 East 8.00

Pine 12 South 15 West 6.00

G.L.O. - Brookfield - 1837

55.00 old post left bank river

80.00 over to marshy island, set post

G.L.O. meander post is shown on Plat of
Boltwoods Addition - 1868

Section line between Section 20 and 21 is
shown on Grand Haven monument map by Brayton
in 1876 and also Peck 1913 Surveys by Peck
1906 and Bowen 1935

B. Description of corner evidence found and/or method applied in restoring or reestablishing corner:

G.L.O. meander post

Re-established the position of the G.L.O. meander post by using the monumentation of the Plat and surveys listed in Part A. The monumentation of the Plat Surveys were in agreement with one another.

Set Ottawa County Remonumentation iron and cap at the G.L.O. meander post and is accepted as a careful and faithful perpetuation of the position of the original corner.

See sketch on back.

C. Description of monument for corner and accessories established to perpetuate locating the position of the corner:

E-7.8 = G.L.O. meander post between Sections 20 and 21

Ottawa County Remonumentation iron and cap Az. = Michigan State Plane grid direction

Remonumentation tag in East side twin 12" Poplar 38° 11' 15.33'

Remonumentation tag in East side power pole 182° 23' 44.82'

Remonumentation tag in Northeast side power pole 146° 22' 149.74'

Southwest corner building, metal siding 126° 54' 140.63'

Northwest corner building, metal siding 96° 07' 154.49'

South bank South channel Grand River 0° 23' 462.00'±

E-7 0° 22' 32" 1650.00'

E-8 180° 11' 52" 990.00'

RECORDED

97 DEC -8 AM 11:41

Sam S. S. S.
REGISTER OF DEEDS
OTTAWA COUNTY, MI

Register of Deeds Stamp & File Number

	A	B	C	D	E	F	G	H	I	J	K	L	N
1													
2	6		5		4		3		2		1		
3													
4	7		8		9		10		11		12		
5													
6	18		17		16		15		14		13		
7													
8	19		20		21		22		23		24		
9													
10	30		29		28		27		26		25		
11													
12	31		32		33		34		35		36		
13													

P.A. 345 OTTAWA COUNTY
PEER APPROVED 12-1-97



YDN

Signed by *Steven Lampen*

Date DECEMBER 1, 1997

Surveyor's Michigan License No. 37279

FORM APPROVED BY MICHIGAN STATE BOARD OF LAND SURVEYORS, JAN. 28, 19
REVISED MAY 14, 19
REVISED JAN., 19
ADAPTED FOR WORD PROCESSING MARCH, 19

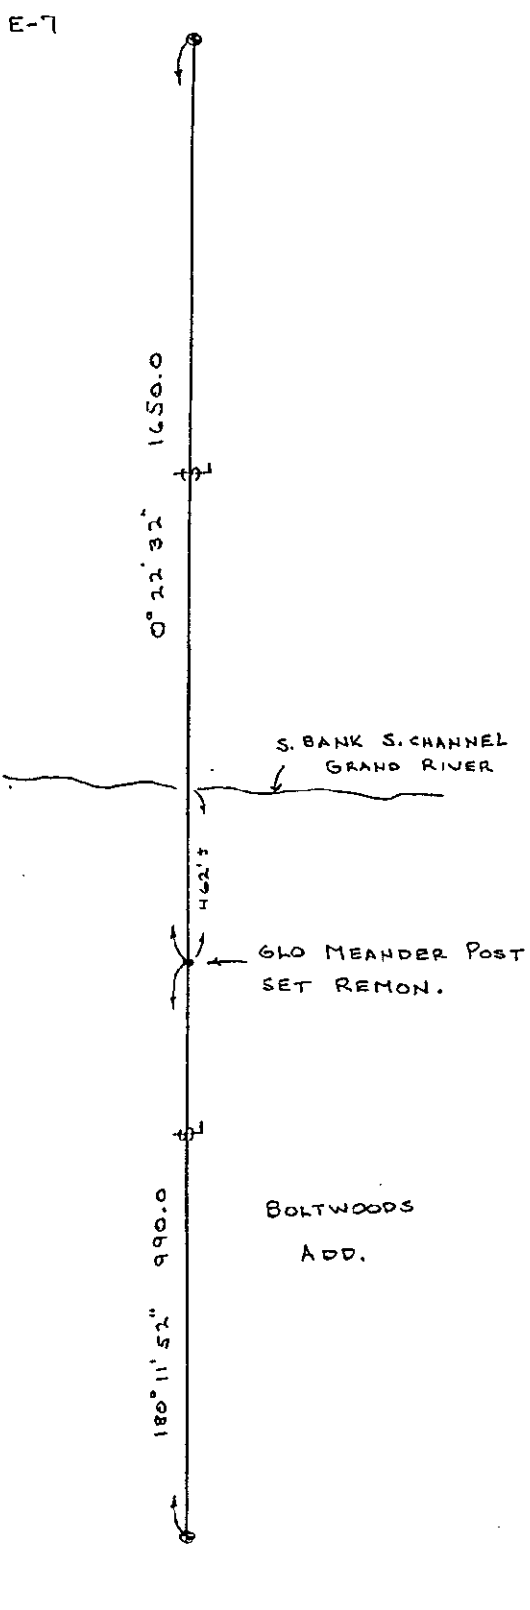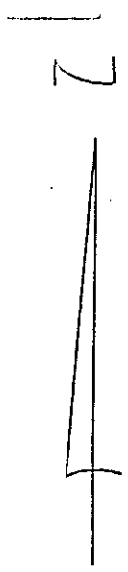

SURVEY &
REMONUMENTATION

FEB 27 1998

SECTION