

OTTAWA COUNTY REMONUMENTATION

LAND CORNER RECORDATION CERTIFICATE Filing Requirement of Act 74, Mich. P.A. 1970

For corners in
Ottawa

(County)

Located In:

Corner Code #

Chester Twp.

1. Public Land Survey

T 9N R 13W

H-5, S 1/4 cor.
Sec. 10

T R

T R

2. Property Controlling
in Section

S

T R

3. Miscellaneous

S

T R

Property in Sec.

S

T R

4. Lot No. , Recorded Plat

5. Private Claims

RECORDED

96 DEC 17 AM 10:42

REGISTER OF DEEDS
OTTAWA COUNTY, MI

Register of Deeds Stamp & File Number

I, Randal D. Feenstra, in a field survey on Oct. 7, 19 96 do hereby state that under requirements of P.A. 74, Michigan P.A. of 1970, the corner points mentioned in lines 1 and 2 above were in conformance with regulations and rules therefore as required in the current manual of survey instructions of the United States Department of the Interior, Bureau of Land Management or by a decree of a Court of Law and/or that the corner points mentioned in lines 3, 4 and 5 above were in conformance with the rules of the Michigan Board of Land Surveyors or by a Decree of a Court of Law; established, re-established, monumented, recovered, found as expressed below:

NOTE: Not more than 2 corners, all in the same town and range, may be recorded on this certificate.

	A	B	C	D	E	F	G	H	I	J	K	L	M
1													
2	6		5		4		3		2		1		
3													
4	7		8		9		10		11		12		
5													
6	18		17		16		15		14		13		
7													
8	19		20		21		22		23		24		
9													
10	30		29		28		27		26		25		
11													
12	31		32		33		34		35		36		
13													

A. Description of original monument and accessories and/or subsequent restoration:

G.L.O. (1838)
Rasselas Whitcomb
Post

30" Sugar Maple N54°W 15 lks
12" Beech N61°E 16 lks

L-6, P-23, 1989

Cor. Hse N80°E 318.58'
8" Apple N20°W 179.98'
Cor. Barn N50°E 223.66'
CL Post N10°W 27.50'
CL Post blacktop E-W


P.A. 345 OTTAWA COUNTY

PEER APPROVED 11-11-96

B. Description of corner evidence found and/or method applied in restoring or reestablishing corner:
H-5 Found: PK

SW Cor. Barn Fndn. NE 233.73'
SE Cor. Hse. Fndn. ENE 318.63'

Accepted as a careful and faithful perpetuation of the position of the original corner.

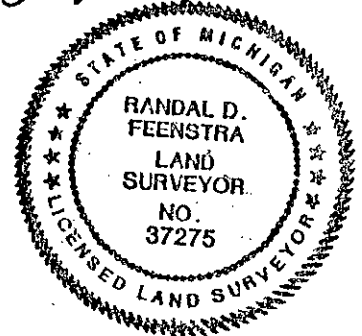

C. Description of monument for corner and accessories established to perpetuate locating the position of the corner:

H-5 Set Ottawa County Remon Bar and Cap in New Monument Box
Ottawa County Remon Nail & Tag in W side 12" Apple N 25°W 203.70'
Ottawa County Remon Nail & Tag in W side 12" Apple N 15° 173.16'
SW Cor. Barn Fndn. N 45°E 233.73'
NW Cor. Barn Fndn. N 35°E 283.86'
SE Cor. Barn. Fndn. N 50°E 261.03'
1' N of CL Hoover

\$9.00 CORNER
\$1.00 PHOTO

Signed by Randal D. Feenstra
Surveyor's Michigan License No. 37275

Date October 10, 1996