

APR 29 1996

COMMISSION

JUDITH D. ROEHM
Ontonagon County

05/09/95
13:13

LAND CORNER RECORDATION CERTIFICATE
Filing Requirement of Act 74, Mich. P.A. 1970

3/ 256 JEH Feet: .00
Page 1 of 1

For corners in
ONTONAGON
(County)

Located In: Corner Code ##

- 1. Public Land Survey T 46N. R 39W. G-5
T _____ R _____
T _____ R _____
T _____ R _____
- 2. Property Controlling S _____ T _____ R _____
in Section S _____ T _____ R _____
- 3. Miscellaneous S _____ T _____ R _____
Property in Sec. S _____ T _____ R _____


Register of Deeds Stamp & File Number

- 4. Lot No. _____, Recorded Plat _____
- 5. Private Claims _____

Section corner of Sections 9, 10, 15 & 16; T46N., R39W.

I, Richard L. Drahn, in a field survey on May 17, 19 94, do hereby certify that under requirements of P.A. 74, Michigan P.A. of 1970, the corner points mentioned in lines 1 and 2 above were in conformance with regulations and rules therefore as required in the current manual of survey instructions of the United States Department of the Interior, Bureau of Land Management or by a decree of a Court of Law and/or that the corner points mentioned in lines 3, 4 and 5 above were in conformance with the rules of the Michigan Board of Land Surveyors or by a Decree of a Court of Law; established, re-established, monumented, re-monumented, recovered, found as expressed below:

NOTE: Not more than 4 corners, all in the same town and range, may be recorded on this certificate.

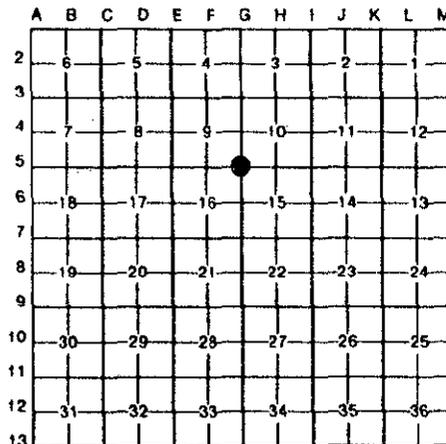

A. Description of original monument and accessories and/or subsequent restoration:

Corner established by Zelotes B. Searls, US Deputy Surveyor, on July 13, 1851. Original bearing trees:

| | | | | |
|---------|----|--------|----------|--------------|
| Fir | 8" | S.41E. | 40 links | (26.40 feet) |
| Hemlock | 8" | N.43W. | 32 links | (21.12 feet) |

Corner monumented on August 27, 1973, by Ottawa National Forest Land Surveyor, Donald D. Lappala, and recorded in U.S.F.S. Liber, Page J-13 of Ontonagon County records on March 11, 1975.

B. Description of corner evidence found and/or method applied in restoring or reestablishing corner:

Additional road records and subsequent survey records of the area all indicate that the corner position monumented in 1973 west of the center line of old Highway 45 is not correct and that the corner, in fact, is positioned on the center line of the old highway.

The 1973 monument has been removed, and the corner remonumented at the correct location.

**ONTONAGON COUNTY
PEER APPROVED**

*Earl W Applekamp
Jan 25, 1995
Ont Co Rep.*



C. Description of monument for corner and accessories established to perpetuate locating the position of the corner:

At the corner position 6" below the center line of Old US-45, I set a 2" galvanized concrete-filled iron pipe with a 3" brass cap stamped to read: T.46N., R.39W.; S-10, S-9, S-15, S-16; 1994; R.L.S. 21564; from which I established the following:

| | | |
|--------------------------|--------|------------|
| W.M.P. Co. Pole #74-0902 | N.12W. | 83.70 feet |
| 4" Balsam | N.78E. | 16.50 feet |
| 8" Aspen | S.20E. | 61.28 feet |
| 6' Steel sign post | N.89W. | 10.90 feet |

A standard 2½" x 30' aluminum pipe reference monument with a 3½' aluminum cap stamped to indicate the correct corner location, bears west 16.50 feet.

Signed by Richard L. Drahn Date January 25, 1995
Surveyor's Michigan License No. 21564
USFS #J-13

256