

SURVEY & REMONUMENTATION

DEC 16 1996

LAND CORNER RECORDATION CERTIFICATE Filing Requirement of Act 74, Mich. P.A. 1970

JUDITH D. ROEHM
Ontonagon County
LC 4/ 33 JEM Fee: 9.00
Page 1 of 1

For corners in COMMISSION

<u>Ontonagon</u> (County)	Located In:	Corner Code #
1. Public Land Survey	T 47N. R 38 W.	T-7
	T R	
	T R	
	T R	
2. Property Controlling in Section	S T R	
	S T R	
3. Miscellaneous Property in Sec.	S T R	
	S T R	
4. Lot No. _____, Recorded Plat _____		
5. Private Claims _____		

Register of Deeds Stamp & File Number

Section Corner 14,15,22,23; T.47 N., R.38 W.

Richard L. Drahn, in a field survey on August 15, 1995, do hereby certify that under requirements of P.A. 74, Michigan P.A. of 1970, the corner points mentioned in lines 1 and 2 above were in conformance with regulations and rules therefore as required in the current manual of survey instructions of the United States Department of the Interior, Bureau of Land Management or by a decree of a Court of Law and/or that the corner points mentioned in lines 3, 4 and 5 above were in conformance with the rules of the Michigan Board of Land Surveyors or by a Decree of a Court of Law; established, re-established, monumented, re-monumented, recovered, found as expressed below:

NOTE: Not more than 4 corners, all in the same town and range, may be recorded on this certificate.

A. Description of original monument and accessories and/or subsequent restoration:

Corner established by Z.B. Searls, Deputy Surveyor on June 16, 1851.
Original bearing trees: --- Cedar 10" S.45 E. 23 links --- W. pine 28" N.71 W. 15 links ---
Wilho J. Perttula, testimony circa 1951
Richard L. Drahn, R.L.S. 21564, monumented this corner on August 4, 1981.
Recorded Liber 2, Page 38 on 6/15/82 in Ontonagon County records.

B. Description of corner evidence found and/or method applied in restoring or reestablishing corner:

Corner monument and Reference Monument destroyed by road re-construction.
Corner position re-monumented from the hole from Power Pole # BA 16 at S.36 E. 41.77 feet and from a 2" by 8' galvanized street sign post at S.65 E., 44.82 feet.

Act 74 Research on file with Ontonagon County Representative.

PEER GROUP APPROVED

Earl W. Applekamp
COUNTY REPRESENTATIVE 1-17-96

C. Description of monument for corner and accessories established to perpetuate locating the position of the corner:


At the corner position I set a sub-surface 2" by 18" iron pipe with a 3" brass cap stamped to read: T.47 N., R.38 W.; S-14, S-15, S-22, S-23; 1995 R.L.S., 21564. From which I established the following new bearing objects:

2 1/2" X 30" alum. Ref. Mon. w/stamped alum. cap bears N.35 E. 37.56 feet
Power Pole # MC 1095 S.35 E. 42.56 feet
15" White Pine S.33 W. 65.69 feet
7" Aspen S.48 E. 83.20 feet
6' Steel rail N.35 E. 38.42 feet

Signed by *Richard L. Drahn*

Date January 17, 1996

Surveyor's Michigan License No. 21564

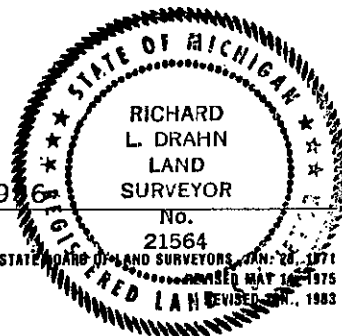

FORM APPROVED BY MICHIGAN STATE BOARD OF LAND SURVEYORS, JAN. 28, 1971
REVISED MAY 12, 1975
REVISED JAN. 1, 1983