

**LAND CORNER RECORDATION CERTIFICATE**  
 Filing Requirement of Act 74, Mich. P.A. 1970

REMO  
 OCT 9 9 1997  
 COMMISSIONER

For corners in

ONTONAGON  
 (County)

Located in: Corner Code #


- |                                    |                   |       |
|------------------------------------|-------------------|-------|
| 1. Public Land Survey              | T 48NR 39W        | M-3   |
|                                    | T 48NR 38W        | A-3 ✓ |
|                                    | T ___ R ___       | _____ |
|                                    | T ___ R ___       | _____ |
| 2. Property Controlling in Section | S ___ T ___ R ___ | _____ |
|                                    | S ___ T ___ R ___ | _____ |
| 3. Miscellaneous Property in Sec.  | S ___ T ___ R ___ | _____ |
|                                    | S ___ T ___ R ___ | _____ |

JUDITH D. ROEHN  
 Ontonagon County  
 4/26/97 JTT Feet: 9.00  
 Page 1 of 1

Register of Deeds Stamp & File Number

4. Lot No. \_\_\_\_\_ Recorded Plat \_\_\_\_\_  
 5. Private Claims \_\_\_\_\_

Corner common to Sections 1, 6, 7 & 12, T48N R38 & 39W.

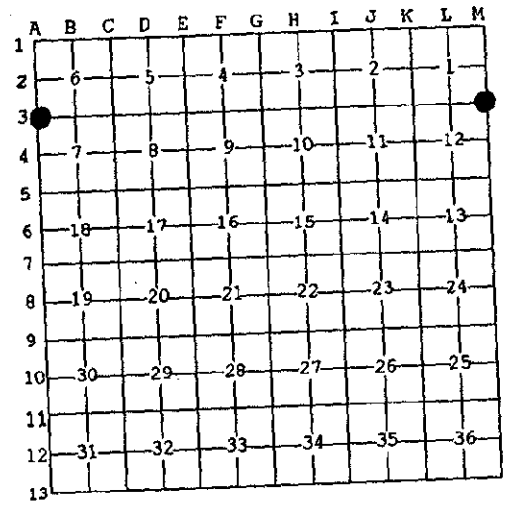

I, Earl W. Applekamp, in a field survey on May 21, 1997 do hereby state that under requirements of P.A. 74, Michigan P.A. of 1970, the corner points mentioned in lines 1 and 2 above were in conformance with regulations and rules therefore as required in the current manual of survey instructions of the United States Department of the Interior, Bureau of Land Management or by a decree of a Court of Law and/or that the corner points mentioned in lines 3, 4 and 5 above were in conformance with the rules of the Michigan Board of Land Surveyors or by a Decree of a Court of Law; established, re-established, monumented, recovered, found as expressed below:

NOTE: Not more than 2 corners, all in the same town and range, may be recorded on this certificate.

A. Description of original monument and accessories and/or subsequent restoration:

Original corner established by Austin Burt, U.S. Deputy Surveyor, July 12, 1847. Set White Birch Post.

ORIGINAL BEARING TREES:

- |            |       |            |
|------------|-------|------------|
| W. Pine 6" | S52°E | 17.16 feet |
| W. Pine 6" | S49°W | 13.20 feet |

PEER GROUP APPROVED  
*Earl W. Applekamp*  
 COUNTY REGISTER  
 6-10-97

B. Description of corner evidence found and/or method applied in restoring or reestablishing corner:

No original evidence was found. An old Township roadway has been graded up and destroyed any evidence. The roadway has never been graveled but has been used. Roadway is now growing trees & brush. A cutting line runs East and a field woods line runs West for a short distance. A fence line runs South on the East side of the road and East from the apparent corner position. The fence line is barely distinguishable. I re-established the corner in the centerline of the road and on line with the fence line running East. Location is in conformance with the original field notes. Research on file with the Ontonagon County Remonumentation Representative.

C. Description of monument for corner and accessories established to perpetuate locating the position of the corner:

At the corner position I set a 2 1/2"x30" aluminum pipe with a 3" cap stamped to read: County Remonumentation, T48N, R38W, R39W, S1, S6, S12, S7, 1997, P.S. 17610.

I established three bearing trees and one reference object.

- |                 |           |        |                   |           |        |
|-----------------|-----------|--------|-------------------|-----------|--------|
| 6" Triple Cedar | N68°-25'W | 71.27' | - 9" Maple        | N82°-12'E | 25.24' |
| 7" Cedar        | N35°-17'E | 91.56' | - Steel Sign Post | S45°W     | 1.10'  |



Signed by Earl W. Applekamp  
 Surveyor's Michigan License No. 17610

Date May 23, 1997